

# SUITE: 1125

# RSF: 1,719



# 700 BRAND

## AS-BUILT CONFIGURATION

OFFICES.....	2
RECEPTION.....	1
CONFERENCE ROOMS.....	1
KITCHEN.....	1
OPEN WORK AREA.....	6

*Not to scale, furniture and appliances not included*

## KEY PLAN

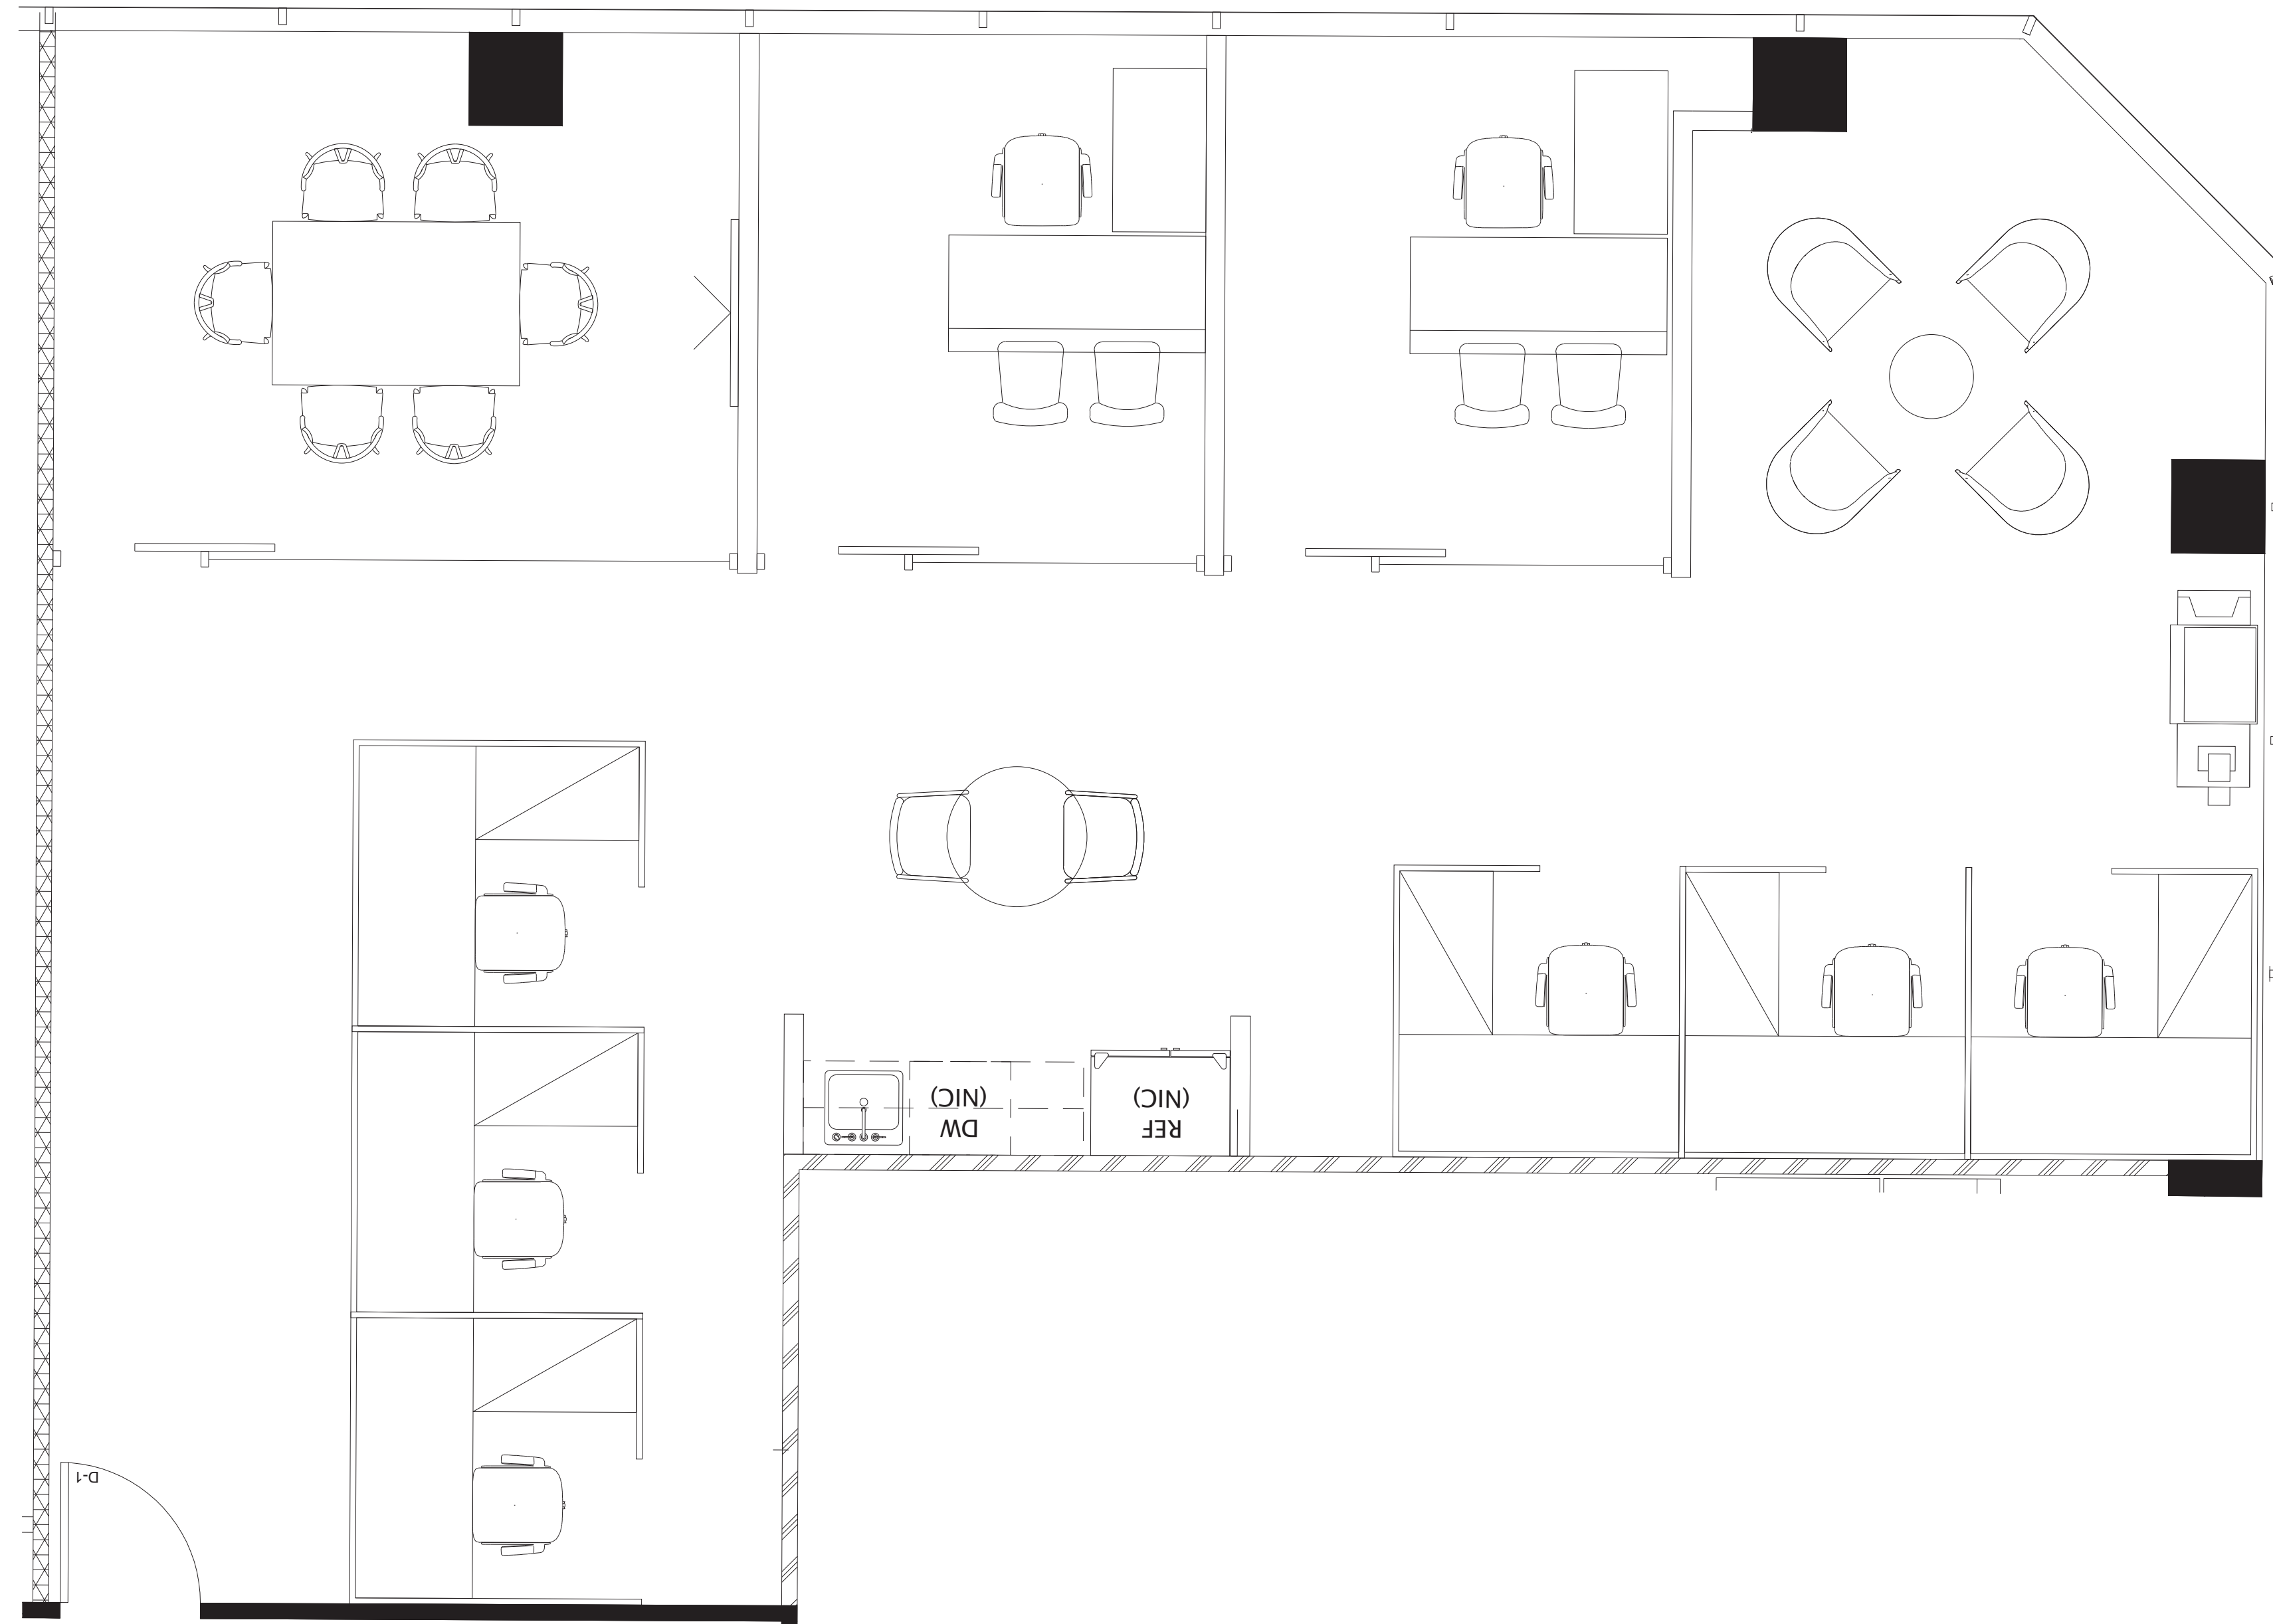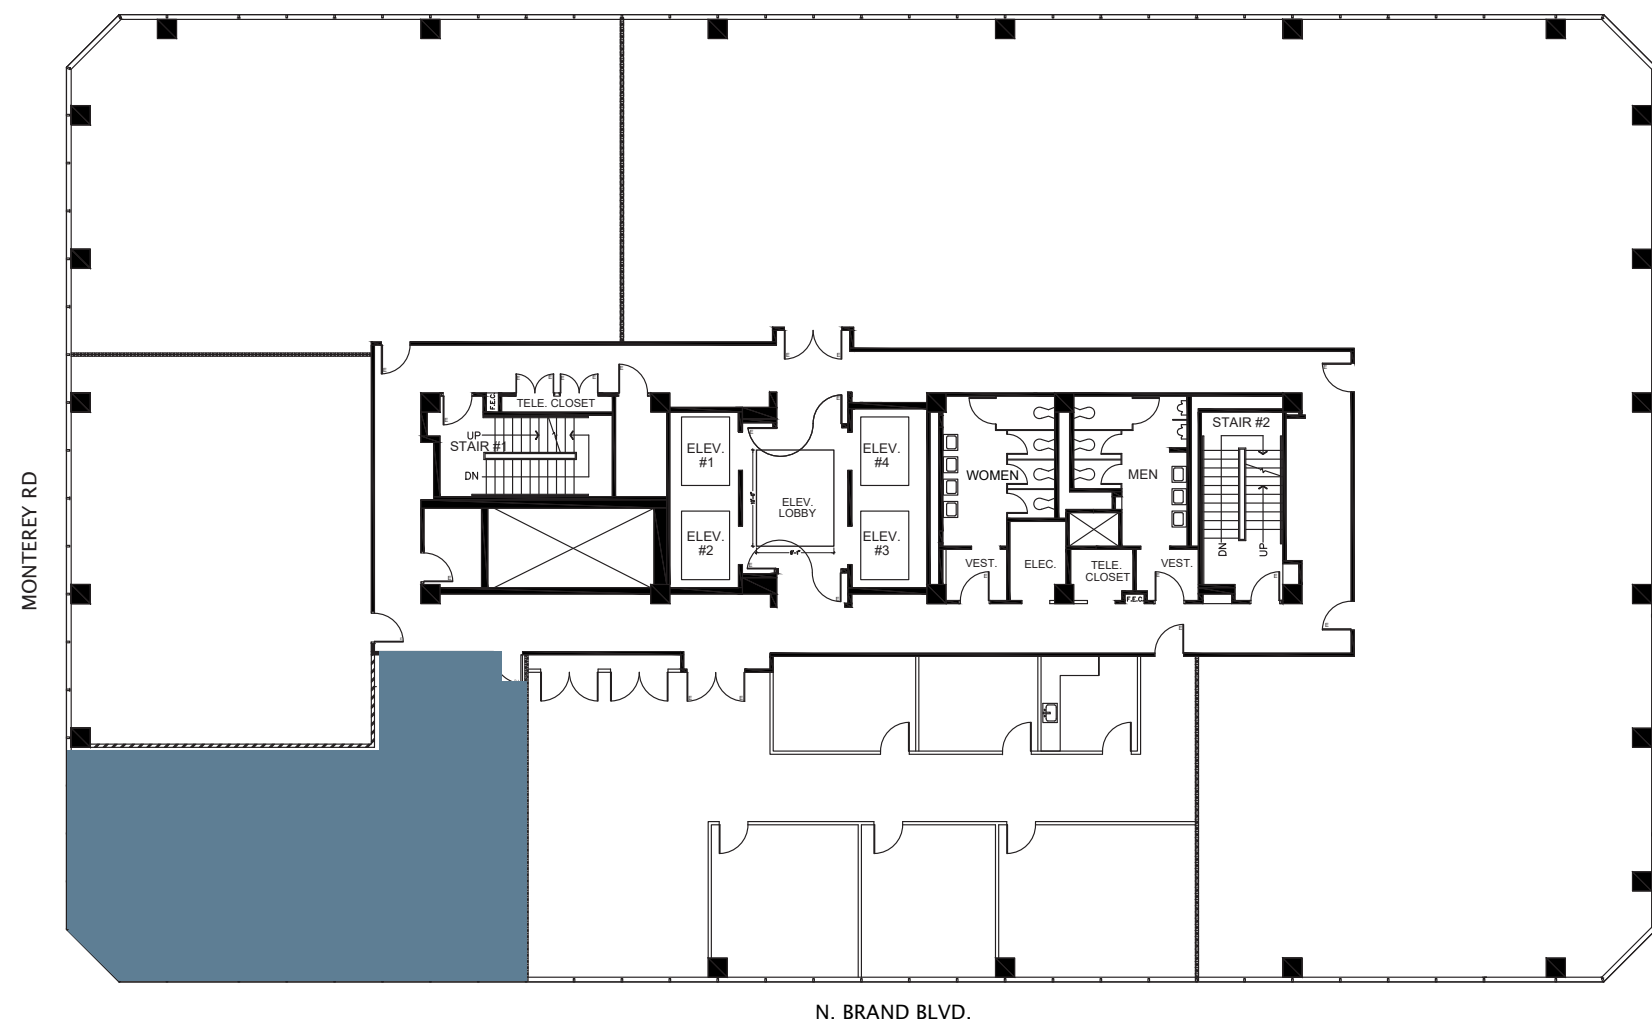

For leasing information please contact:  
Scott A. Unger  
626.873.1803 | [scott.unger@kidder.com](mailto:scott.unger@kidder.com)