

SUITE: 330

RSF: 10,379



700BRAND

AS-BUILT CONFIGURATION

OFFICES.....	18
RECEPTION.....	2
CONFERENCE ROOMS.....	3
KITCHEN.....	1
OPEN WORK AREA.....	+/- 26

Not to scale, furniture and appliances not included

KEY PLAN

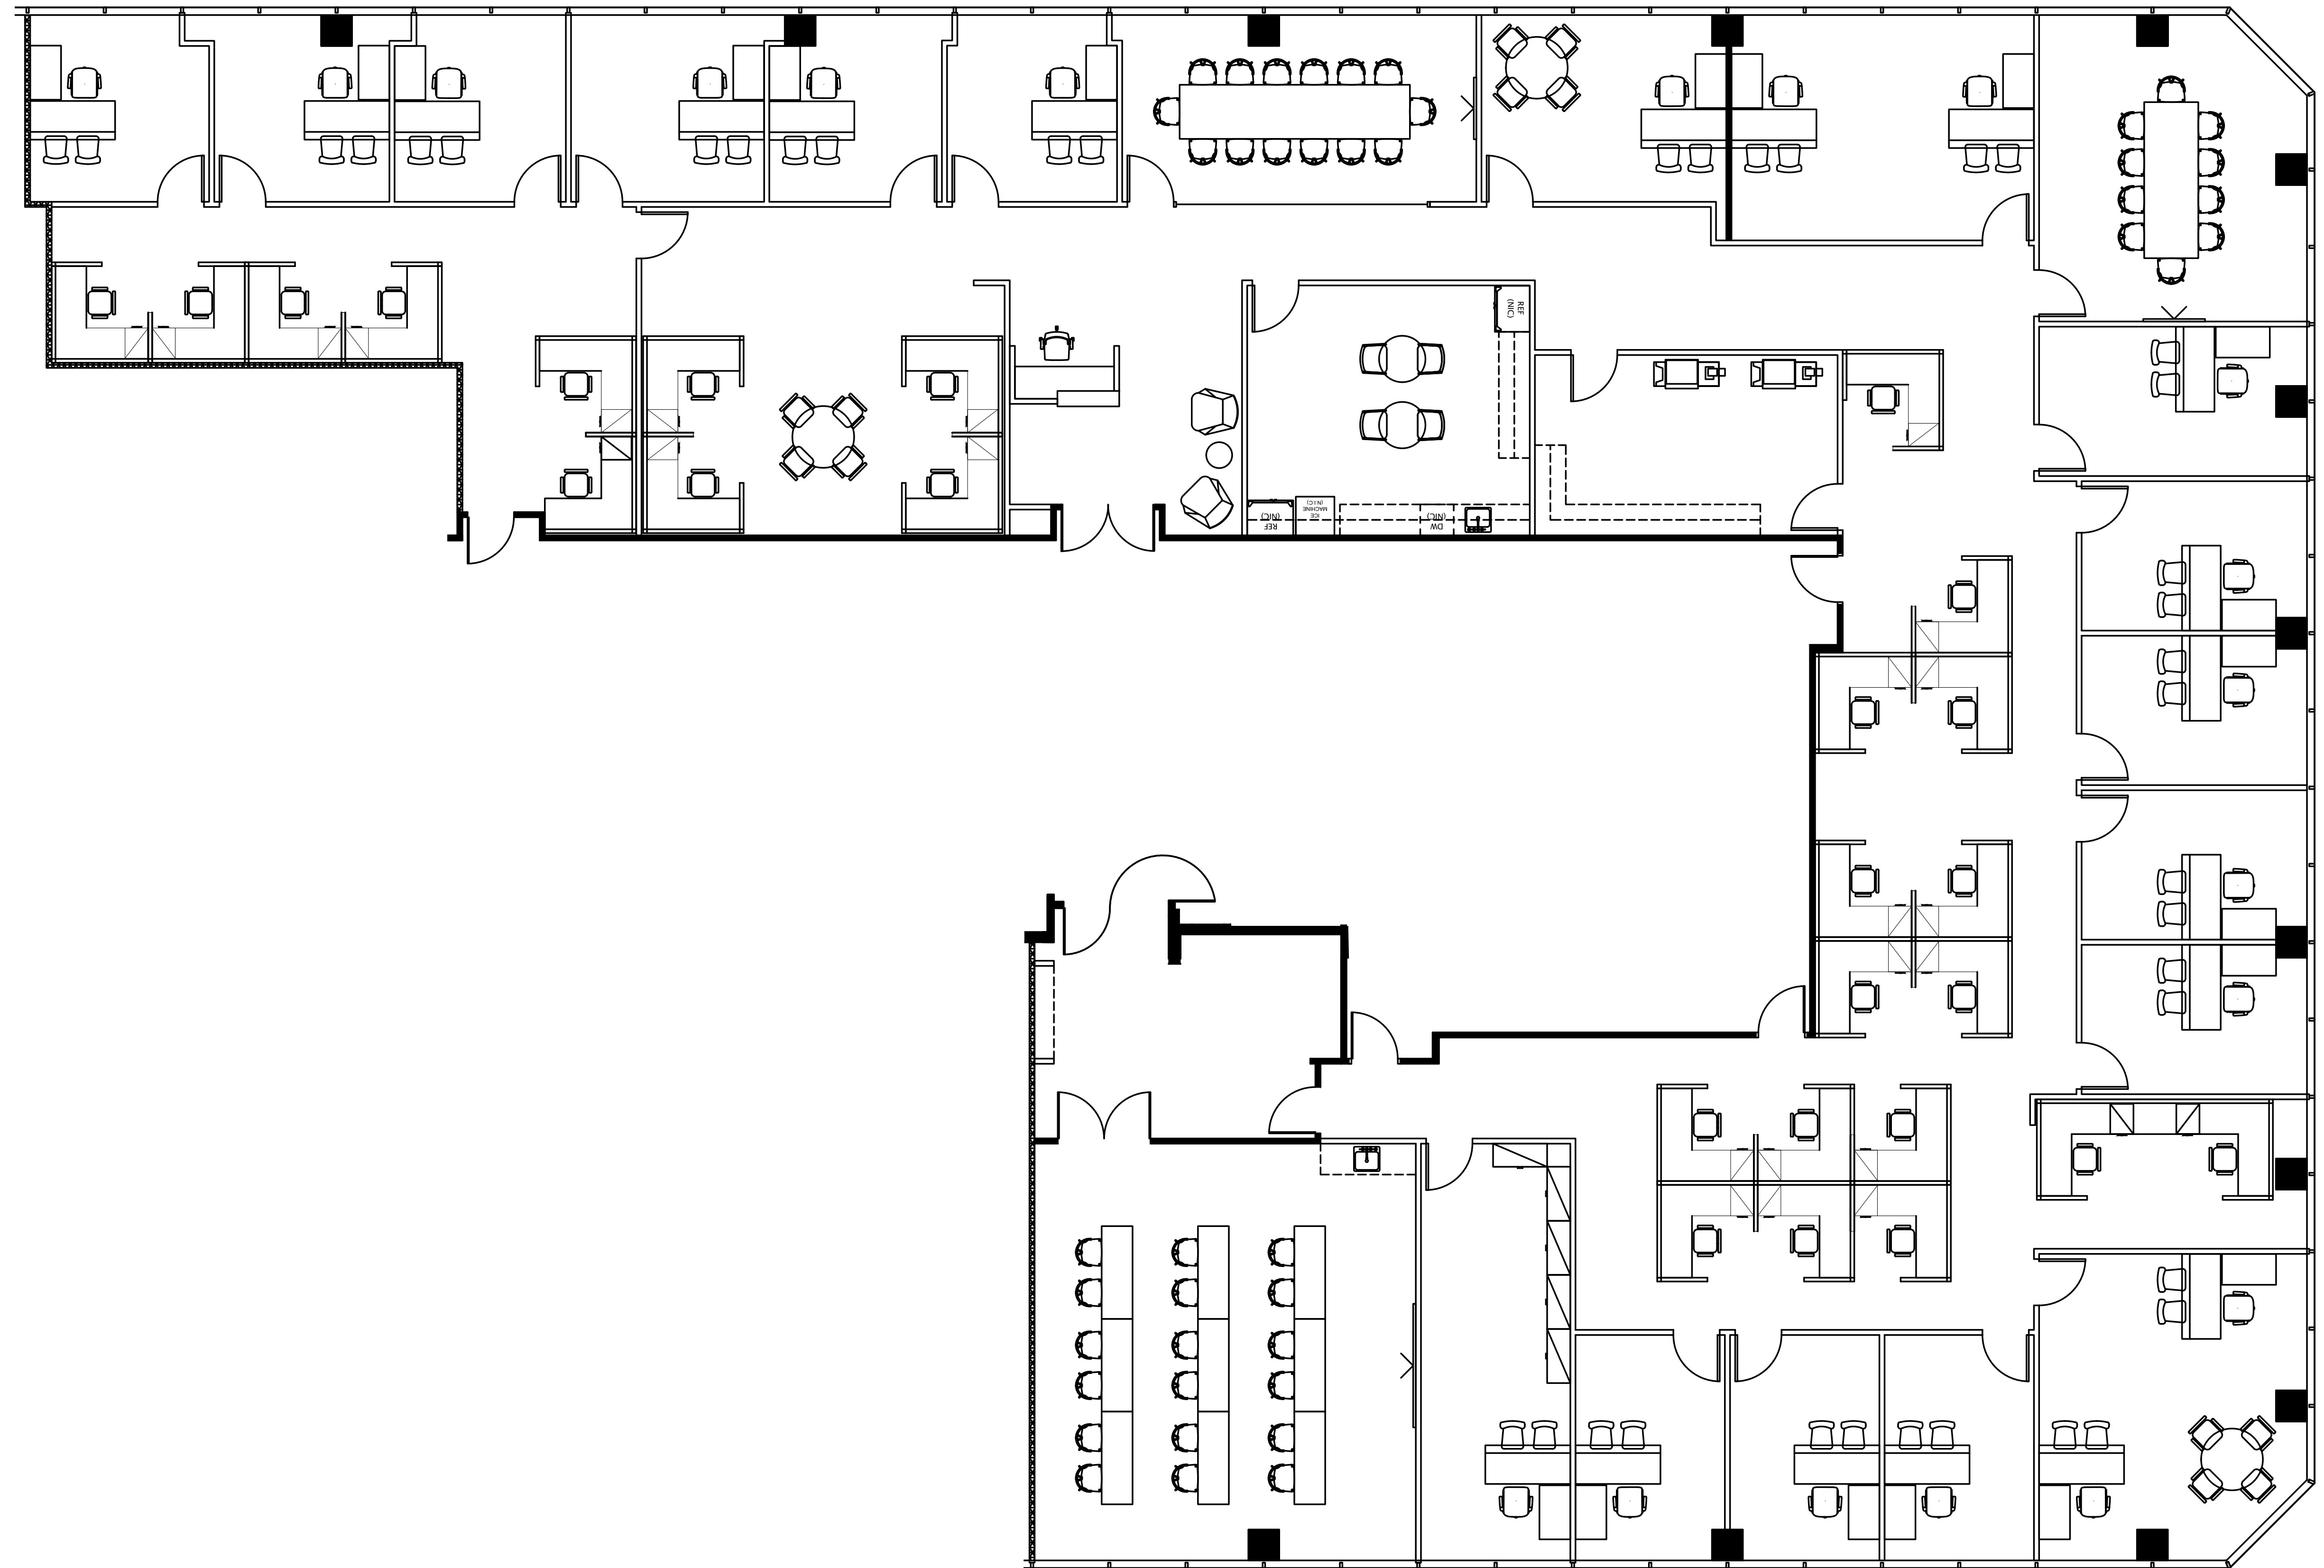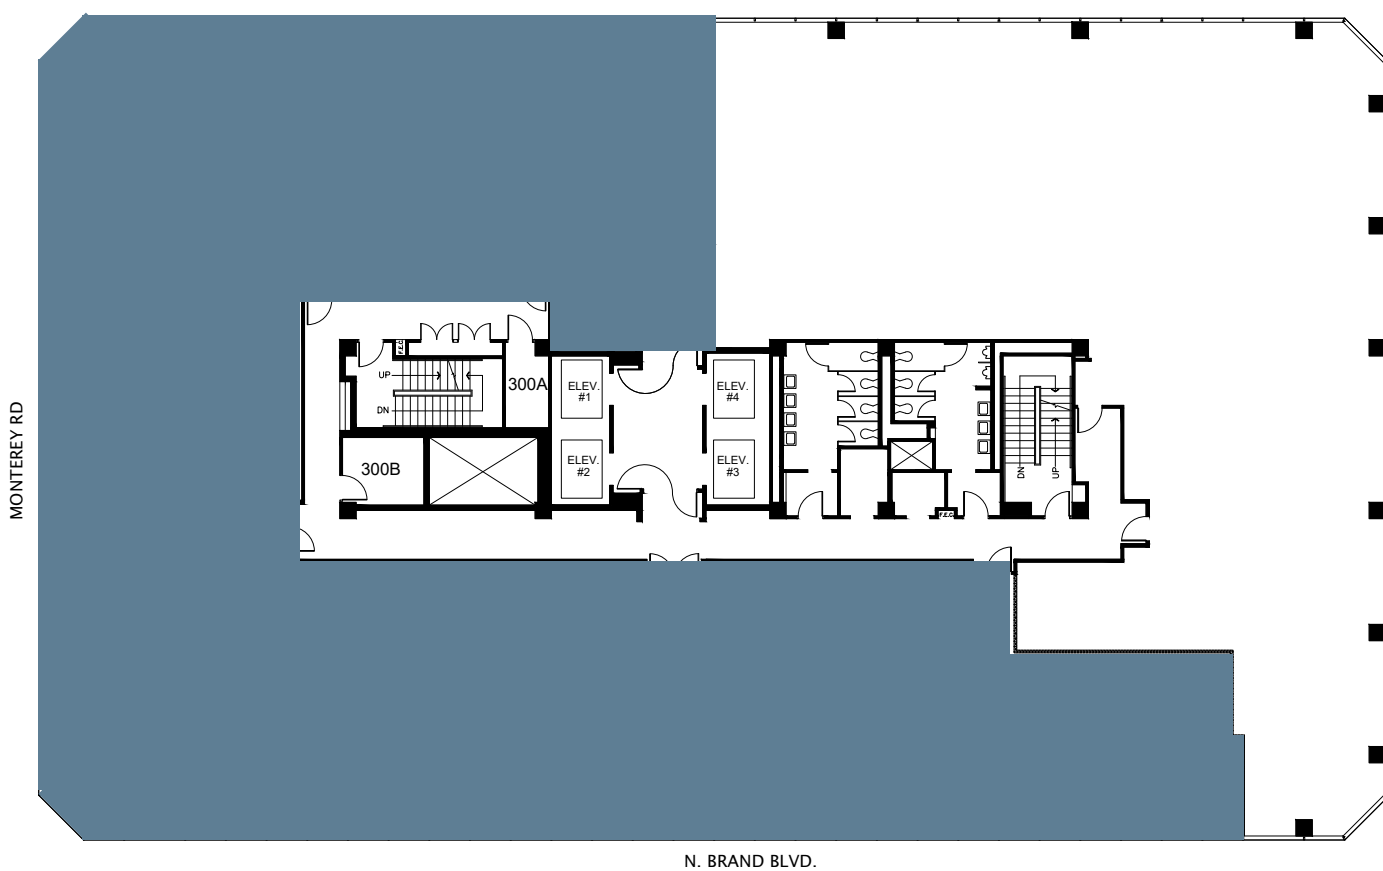

For leasing information please contact:
Scott A. Unger
626.873.1803 | scott.unger@kidder.com

