
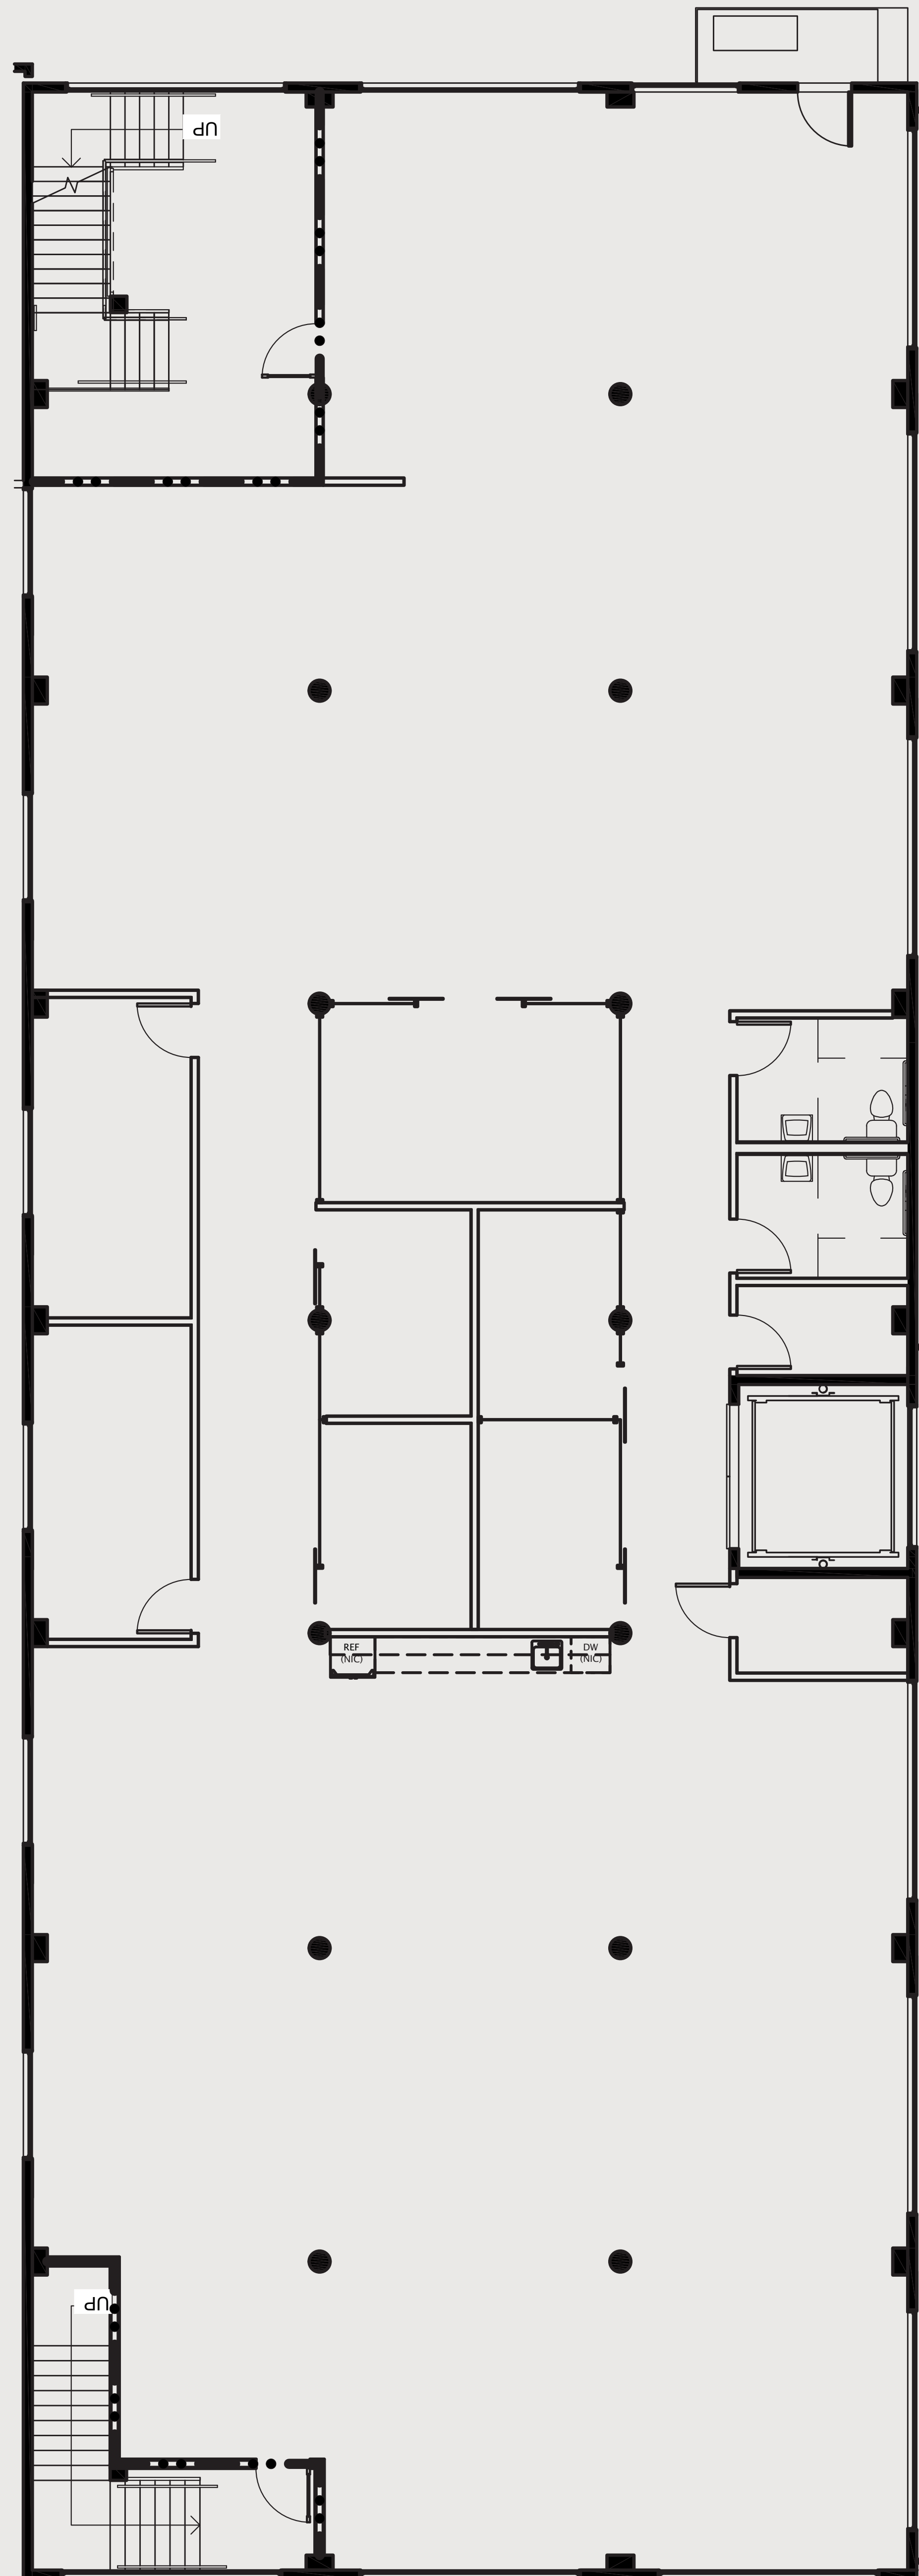


AS-BUILT CONFIGURATION

OFFICES.....	6
RECEPTION.....	1
CONFERENCE ROOMS.....	1
KITCHEN.....	1
OPEN WORK AREA.....	TBD

Not to scale, furniture and appliances not included

KEY PLAN

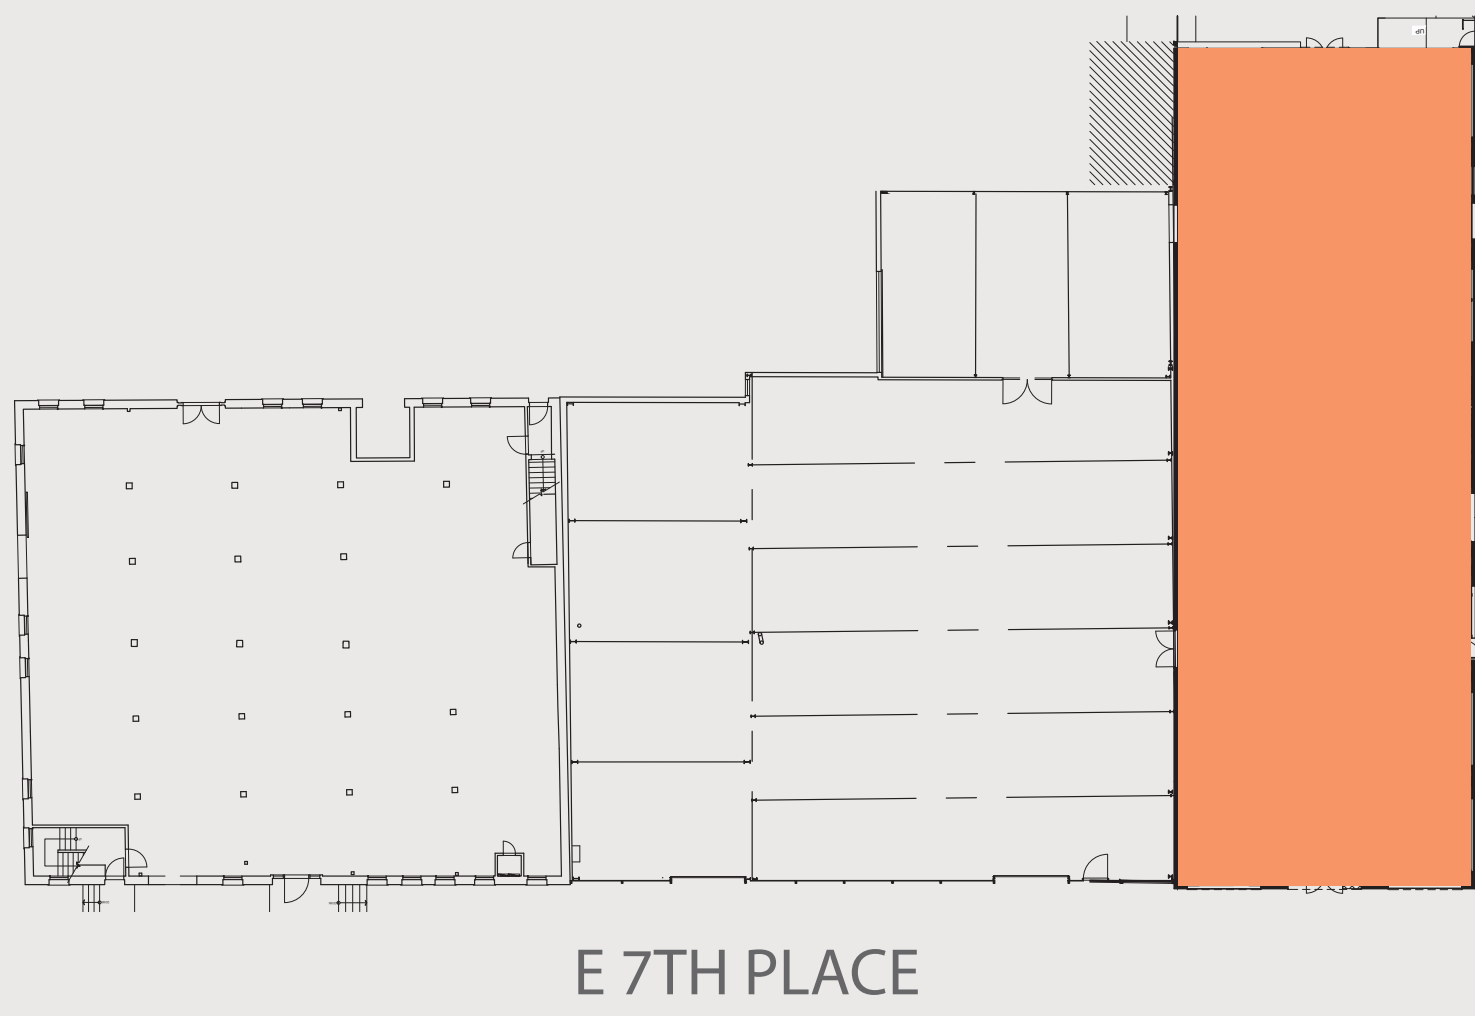

E 7TH PLACE

For leasing information please contact:
Neal Linthicum
310.427.1314 nlinthicum@onni.com