


AS-BUILT CONFIGURATION

OFFICES.....	5
RECEPTION.....	1
CONFERENCE ROOMS.....	2
KITCHEN.....	1
OPEN WORK AREA.....	+/- 42

Not to scale, furniture and appliances not included

KEY PLAN

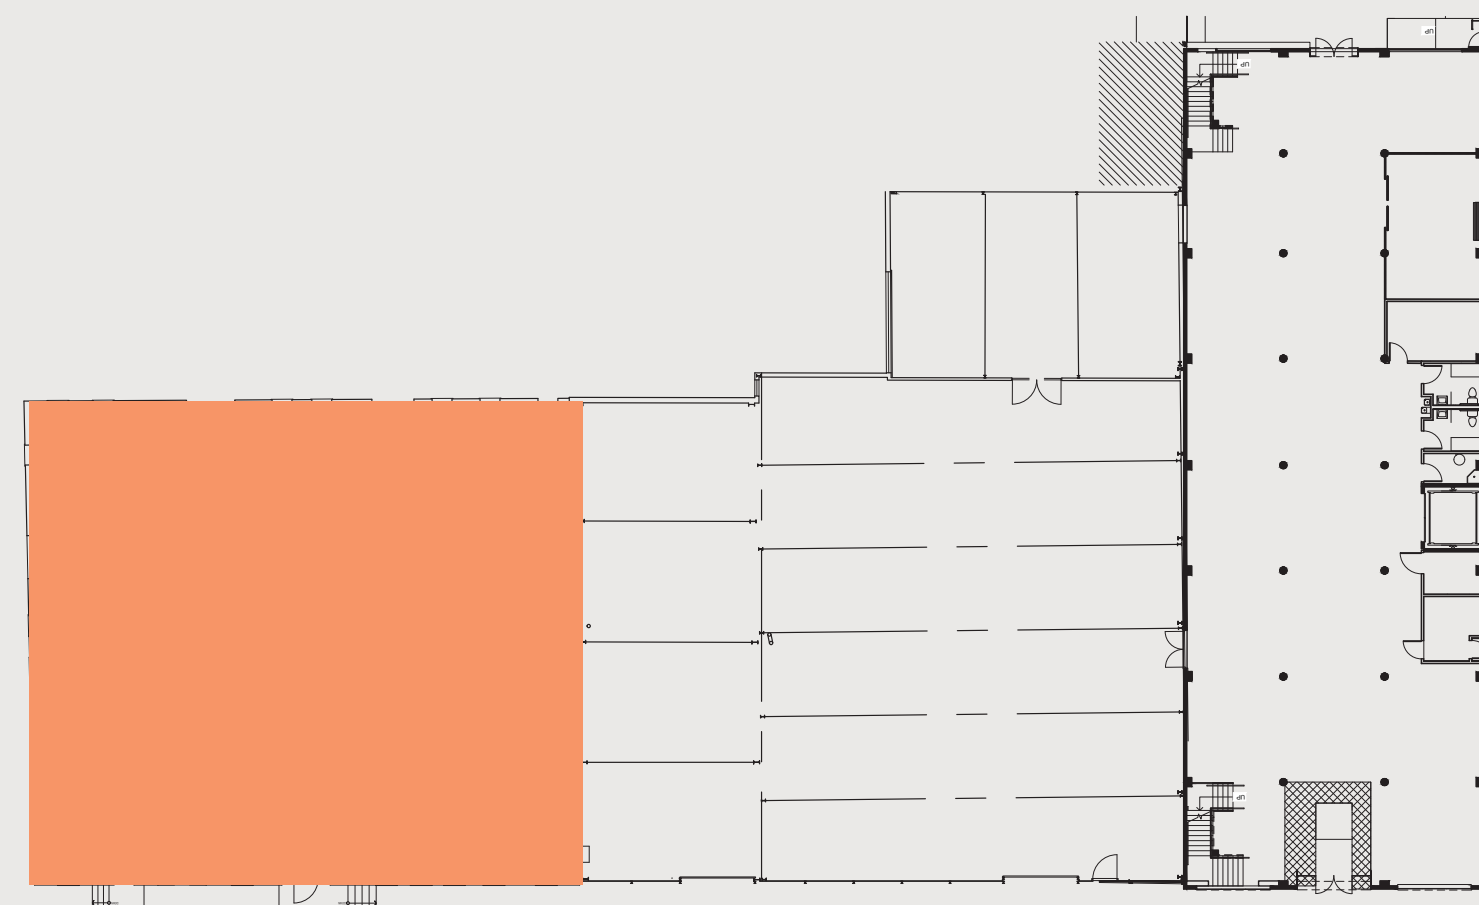

E 7TH PLACE

