
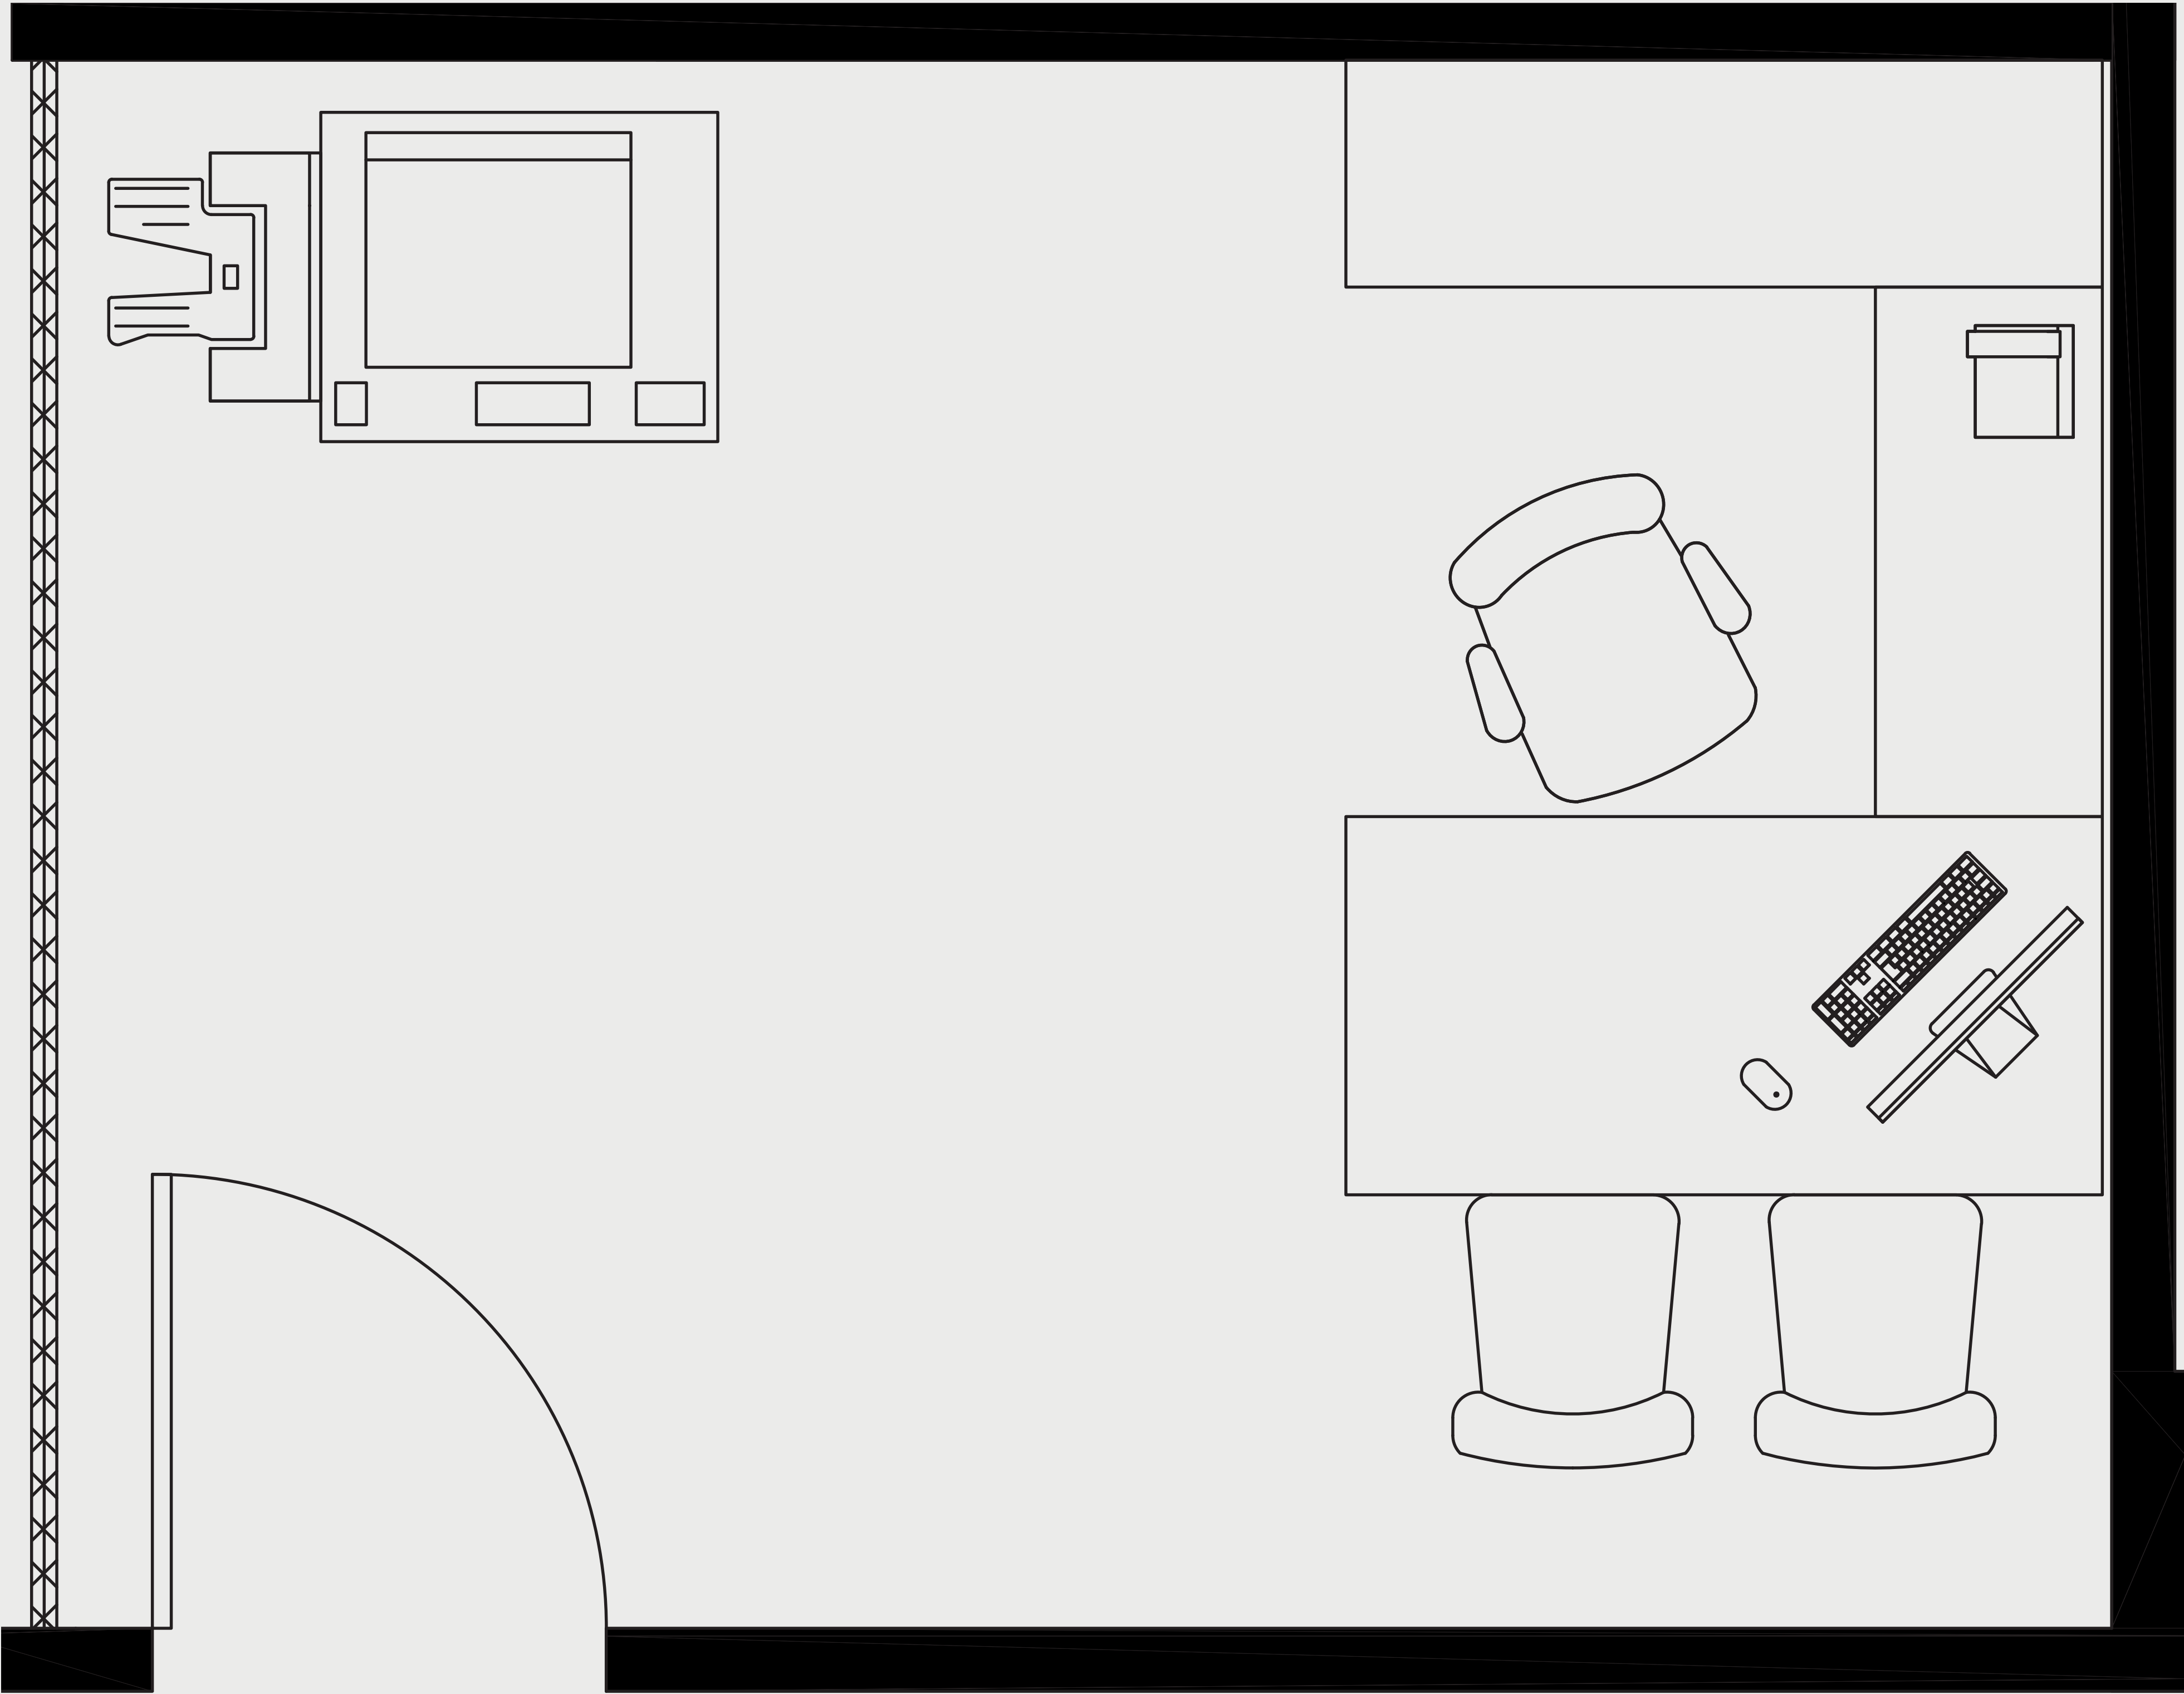


AS-BUILT CONFIGURATION

- OFFICES..... N/A
- RECEPTION..... N/A
- CONFERENCE ROOMS..... N/A
- KITCHEN/BREAKOUT N/A
- OPEN WORK AREA..... N/A

KEY PLAN

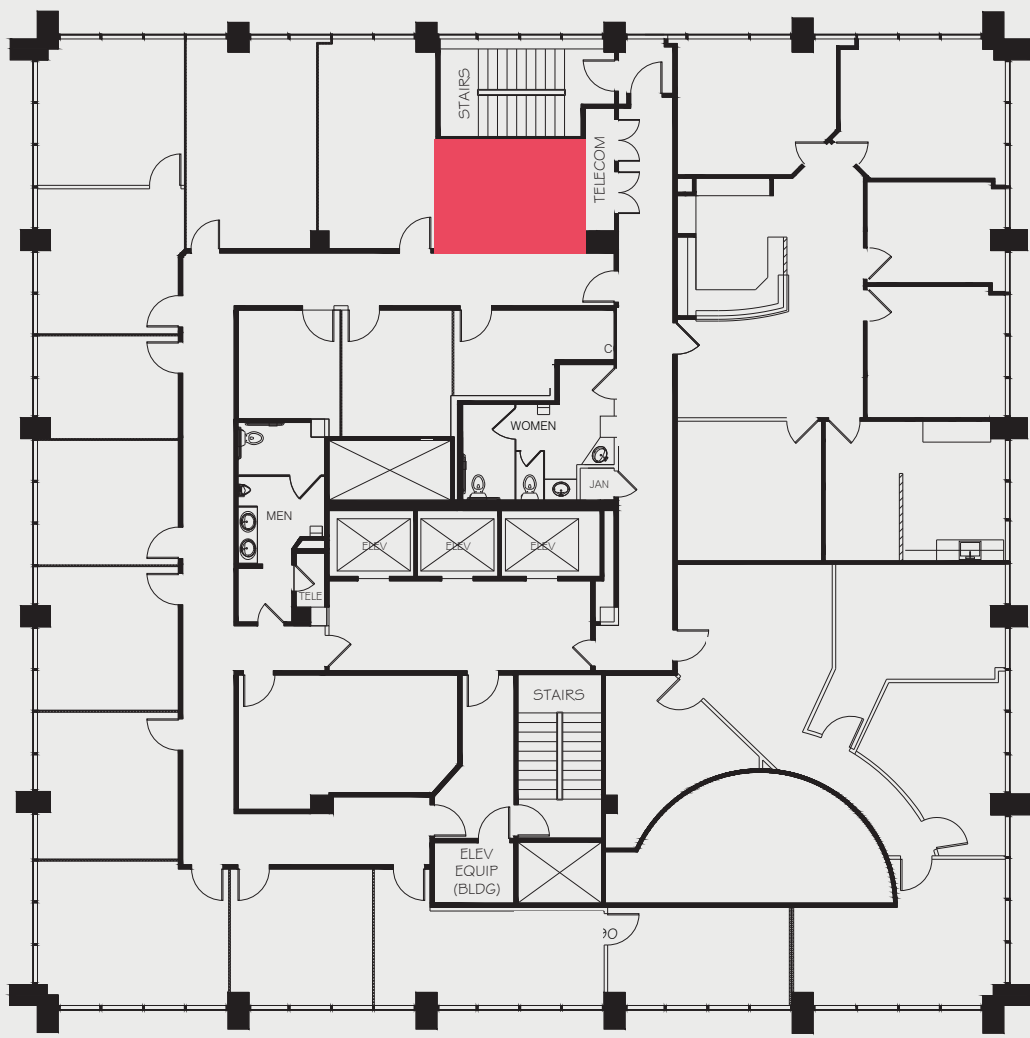

For leasing information please contact:

Bill Boyd
626.873.1801 bill.boyd@kidder.com

Scott Unger
626.873.1803 scott.under@kidder.com

Linda Lee
626.873.1802 linda.lee@kidder.com

