
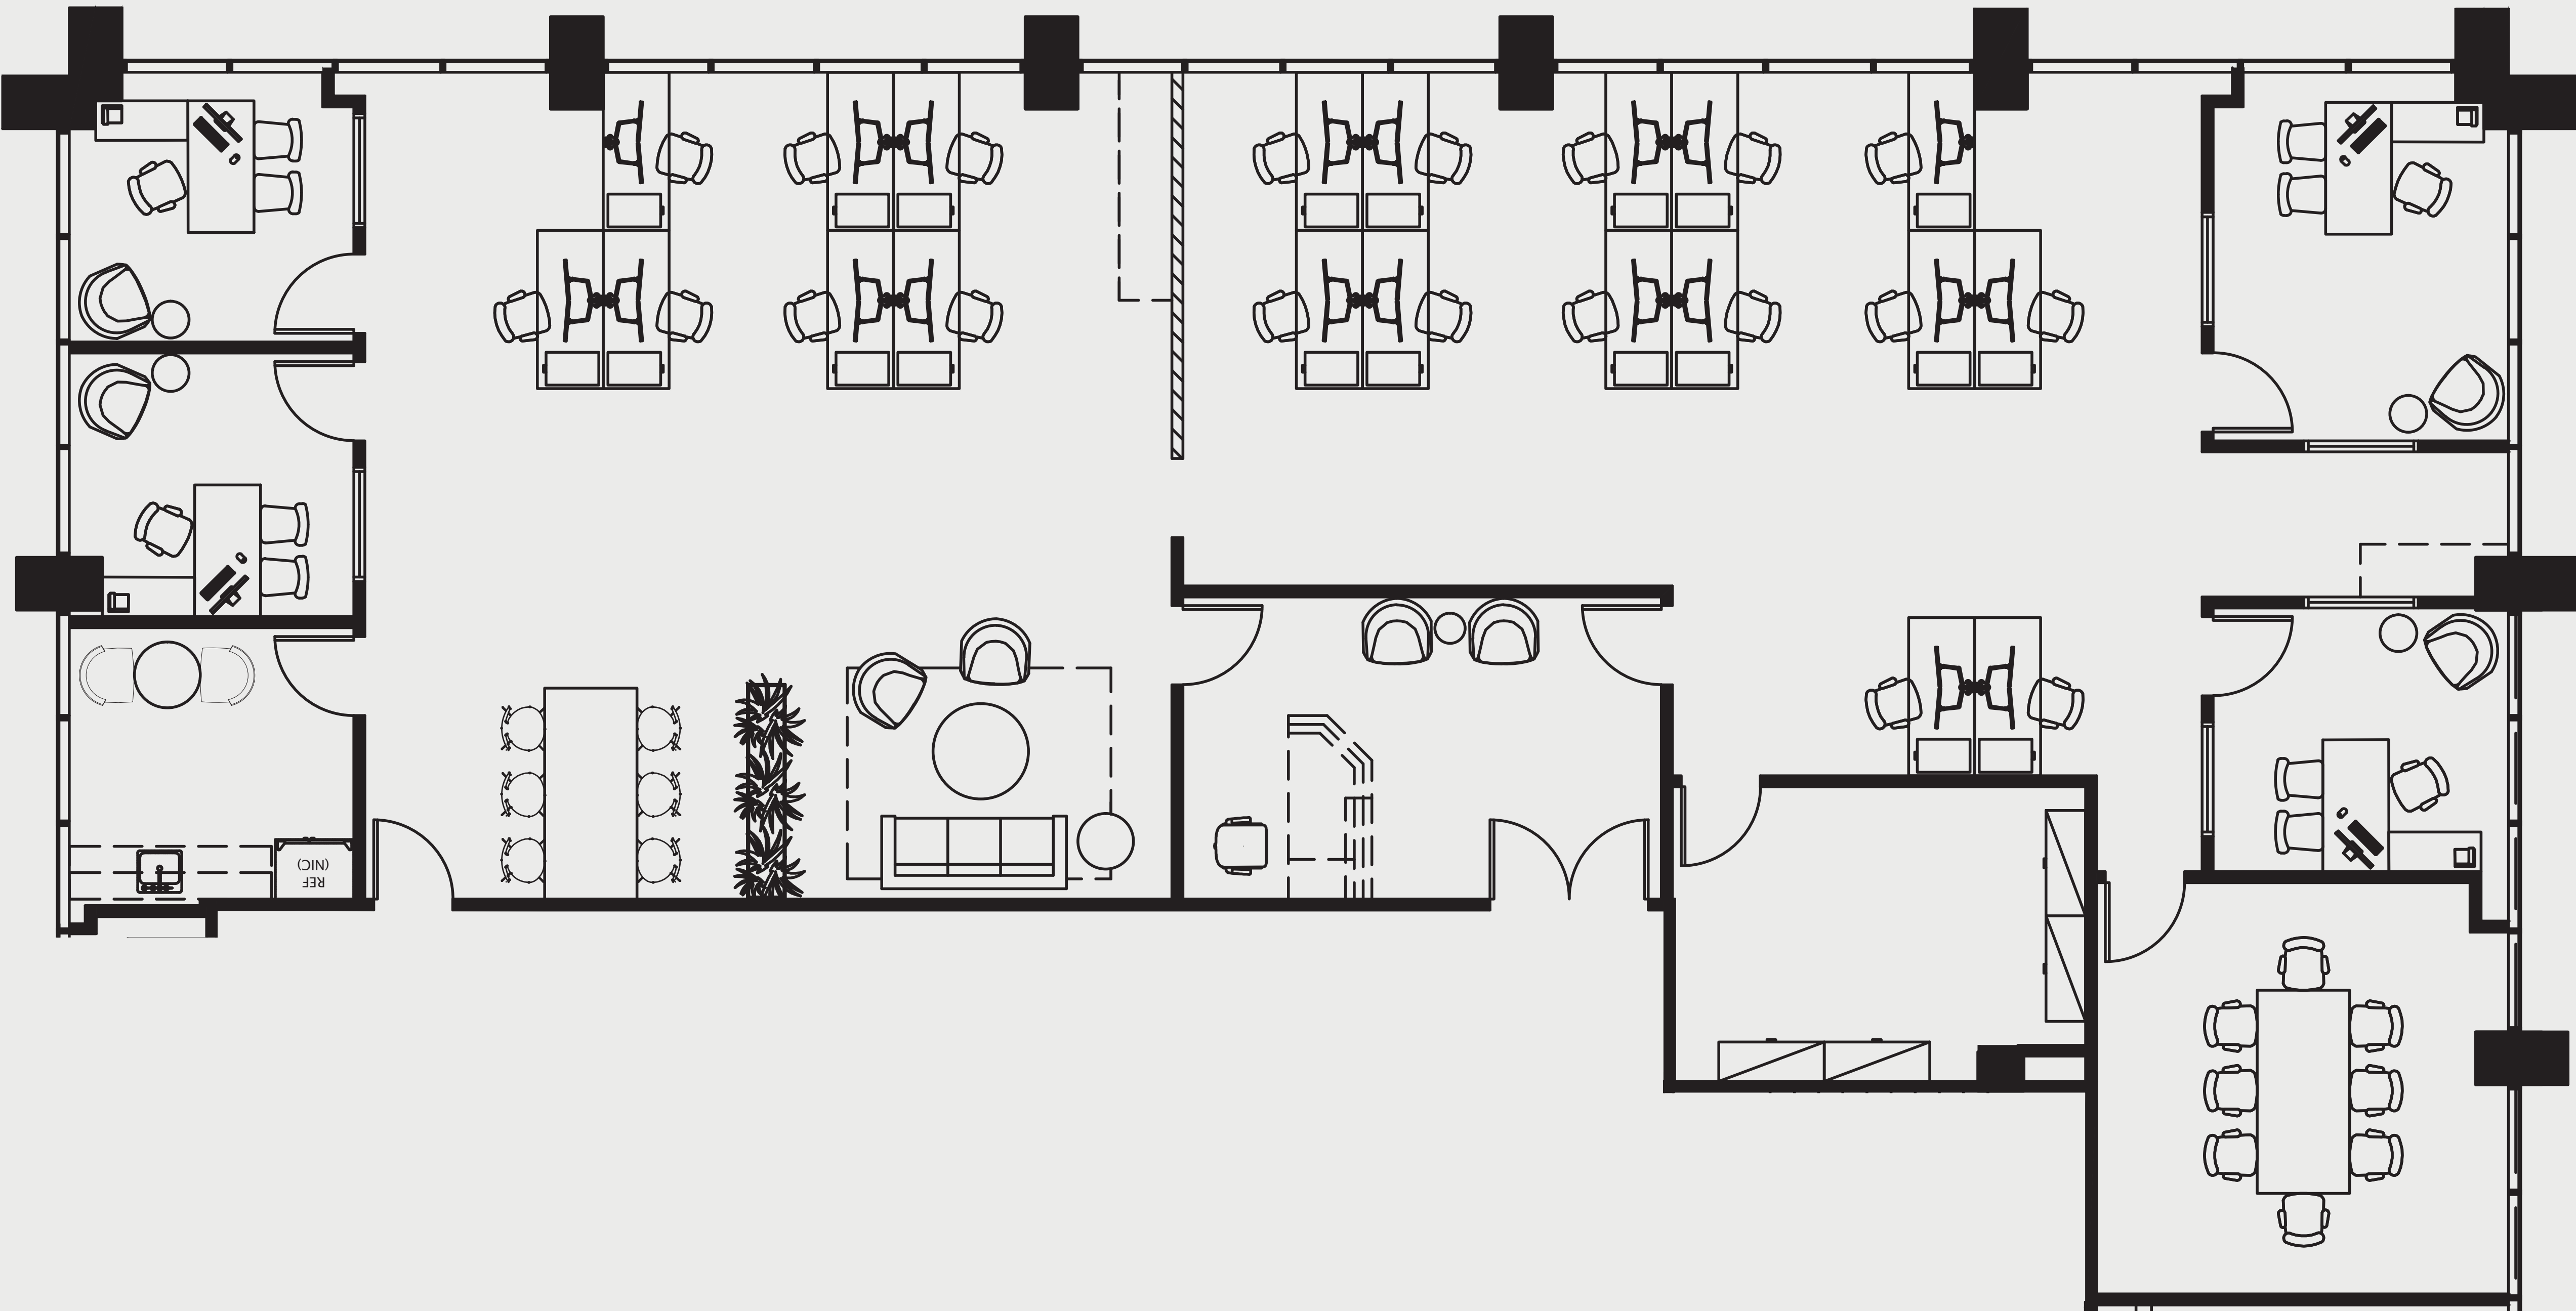


AS-BUILT CONFIGURATION

OFFICES.....	4
RECEPTION.....	1
CONFERENCE ROOMS.....	1
KITCHEN/BREAKOUT .....	1
OPEN WORK AREA.....	+/- 20

KEY PLAN

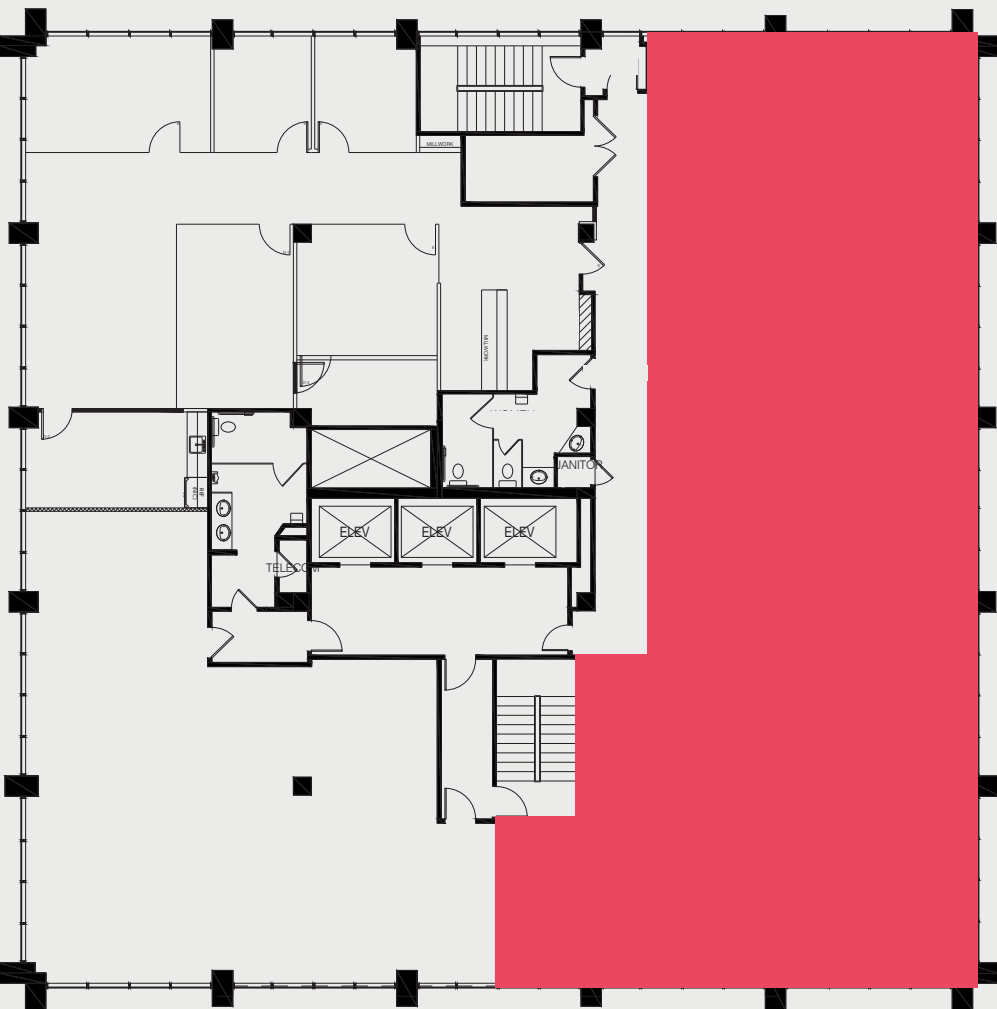

For leasing information please contact:

Bill Boyd  
626.873.1801    bill.boyd@kidder.com

Scott Unger  
626.873.1803    scott.under@kidder.com

Linda Lee  
626.873.1802    linda.lee@kidder.com

