

SUITE: 300

RSF: 5,942



700 BRAND

AS-BUILT CONFIGURATION

- PRIVATE OFFICES..... 11
- CONFERENCE ROOMS..... 3
- KITCHEN..... 1
- OPEN WORK AREA..... +/- 12

Not to scale, furniture and appliances not included

KEY PLAN

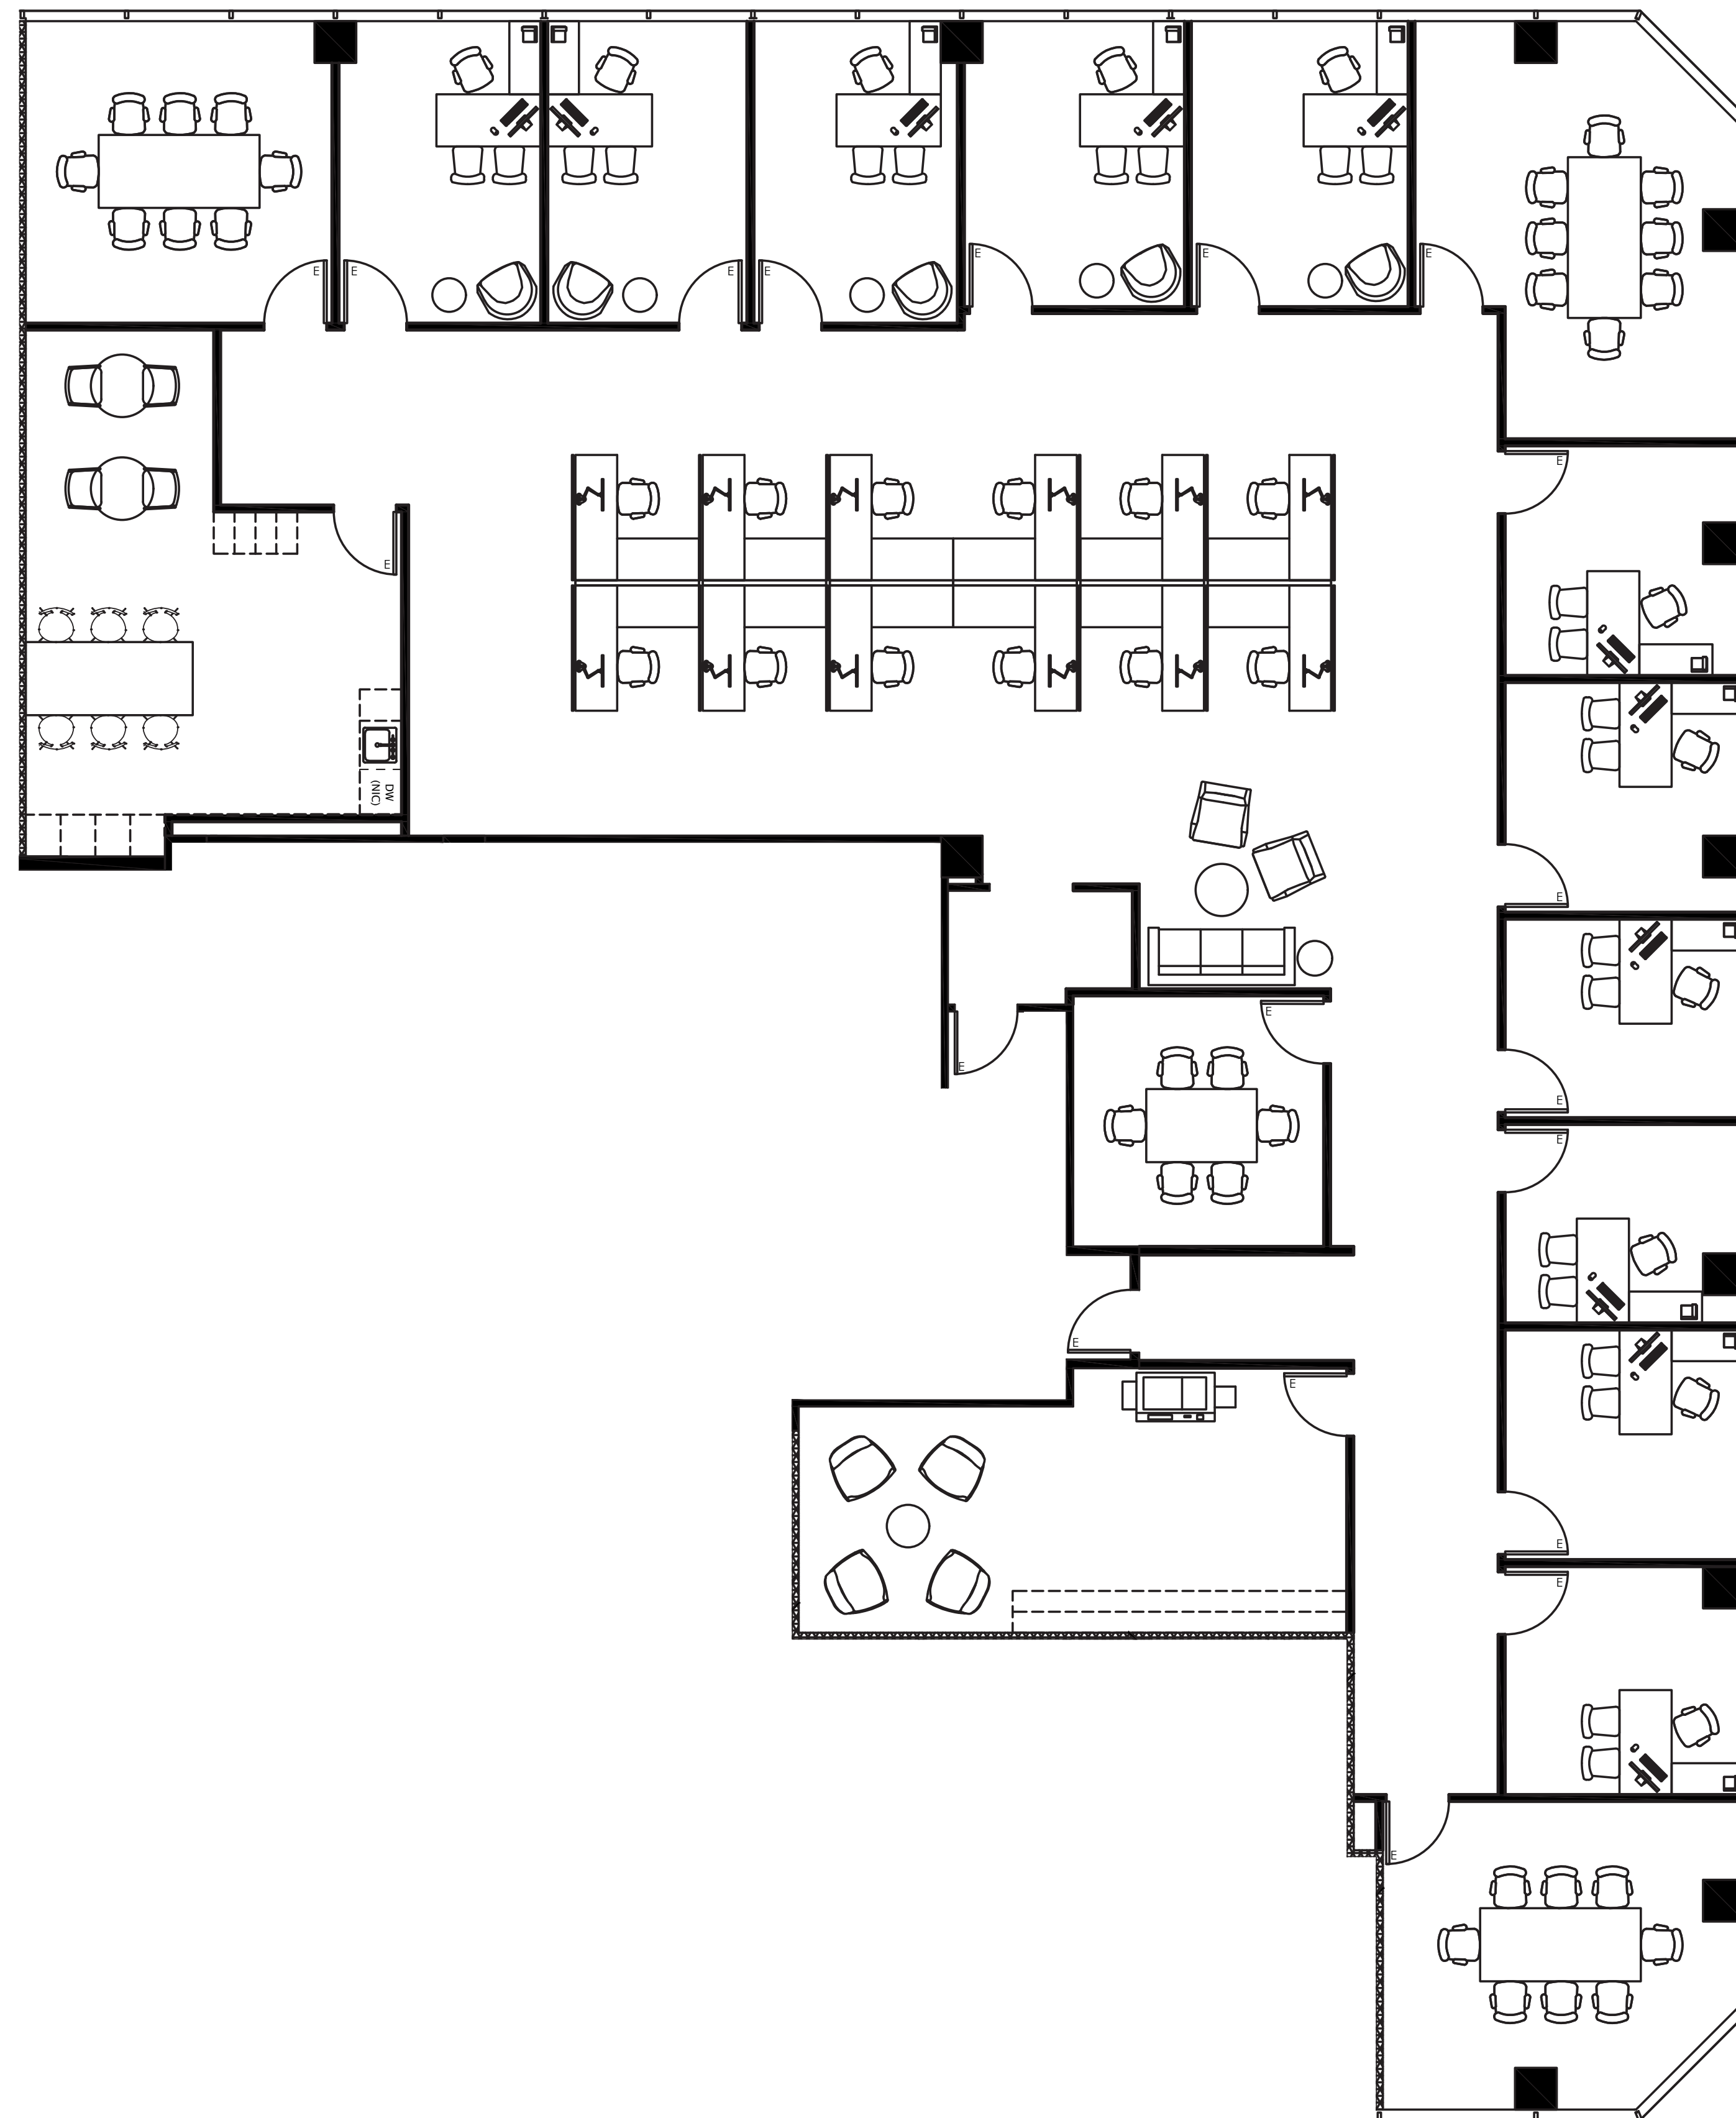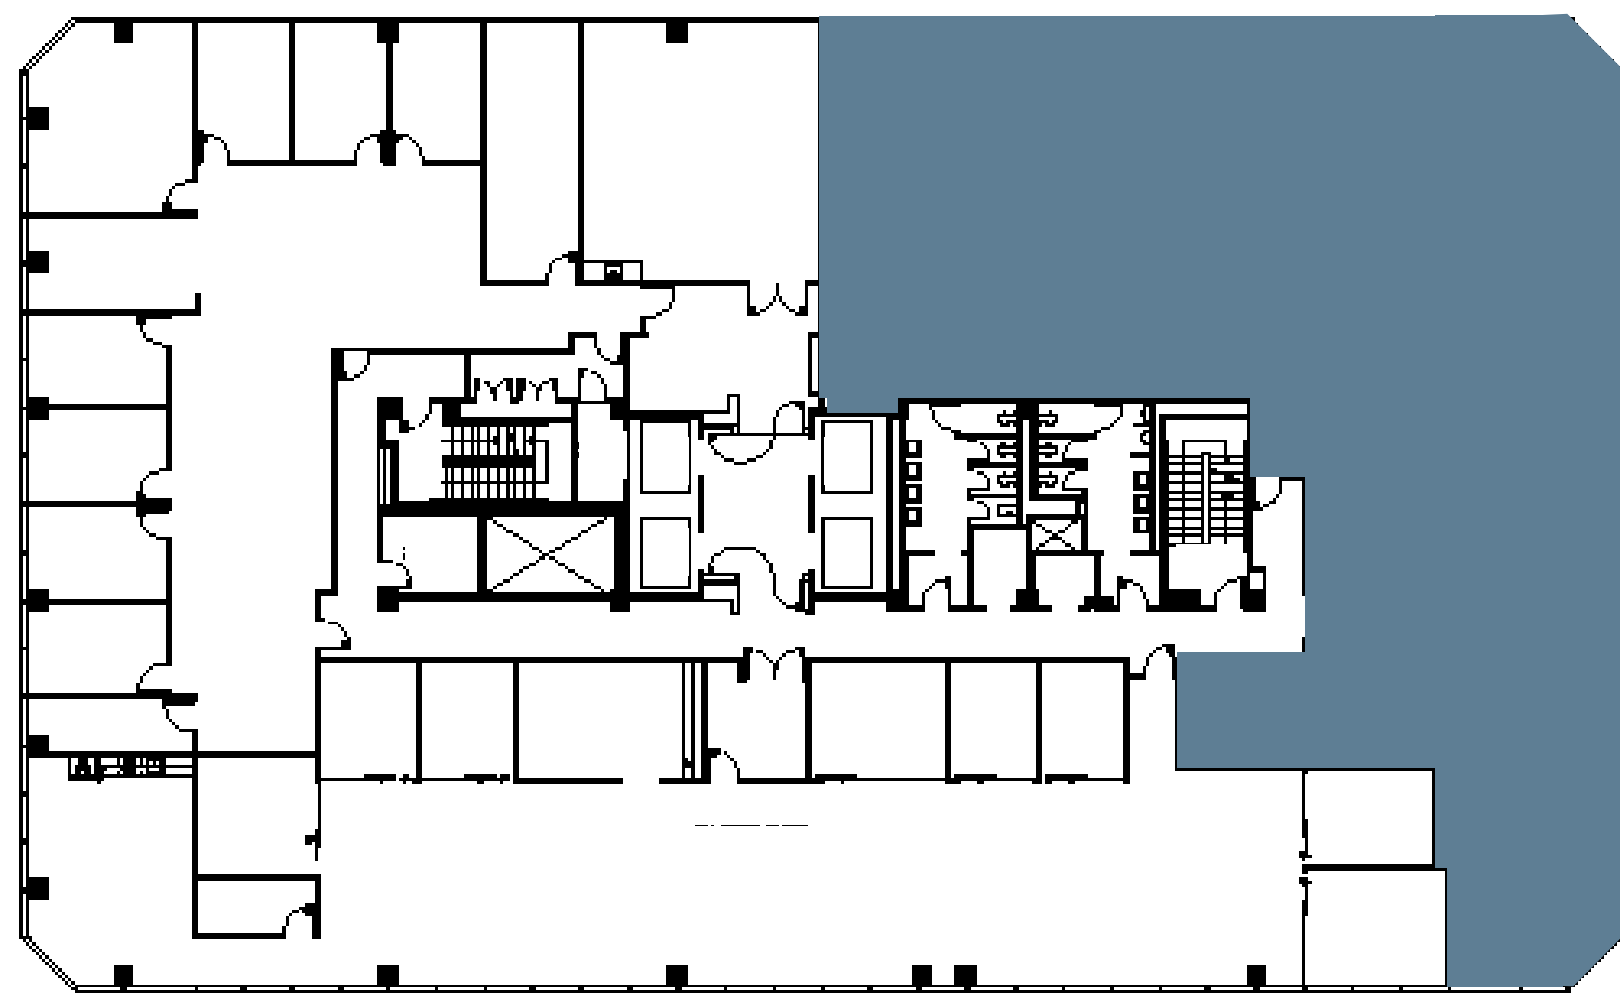

For leasing information please contact:
Scott A. Unger
626.873.1803 | scott.unger@kidder.com