

RETAIL SPACE

GROUND FLR RSF: 12,257


MEZZ RSF: 3,508

535 BRAND


AS-BUILT CONFIGURATION

OFFICES.....	3
RECEPTION.....	1
VAULT.....	4
PRIVATE ROOM.....	2
BREAKROOM.....	2
MEETING AREA.....	2
BANK TELLER.....	1

KEY PLAN

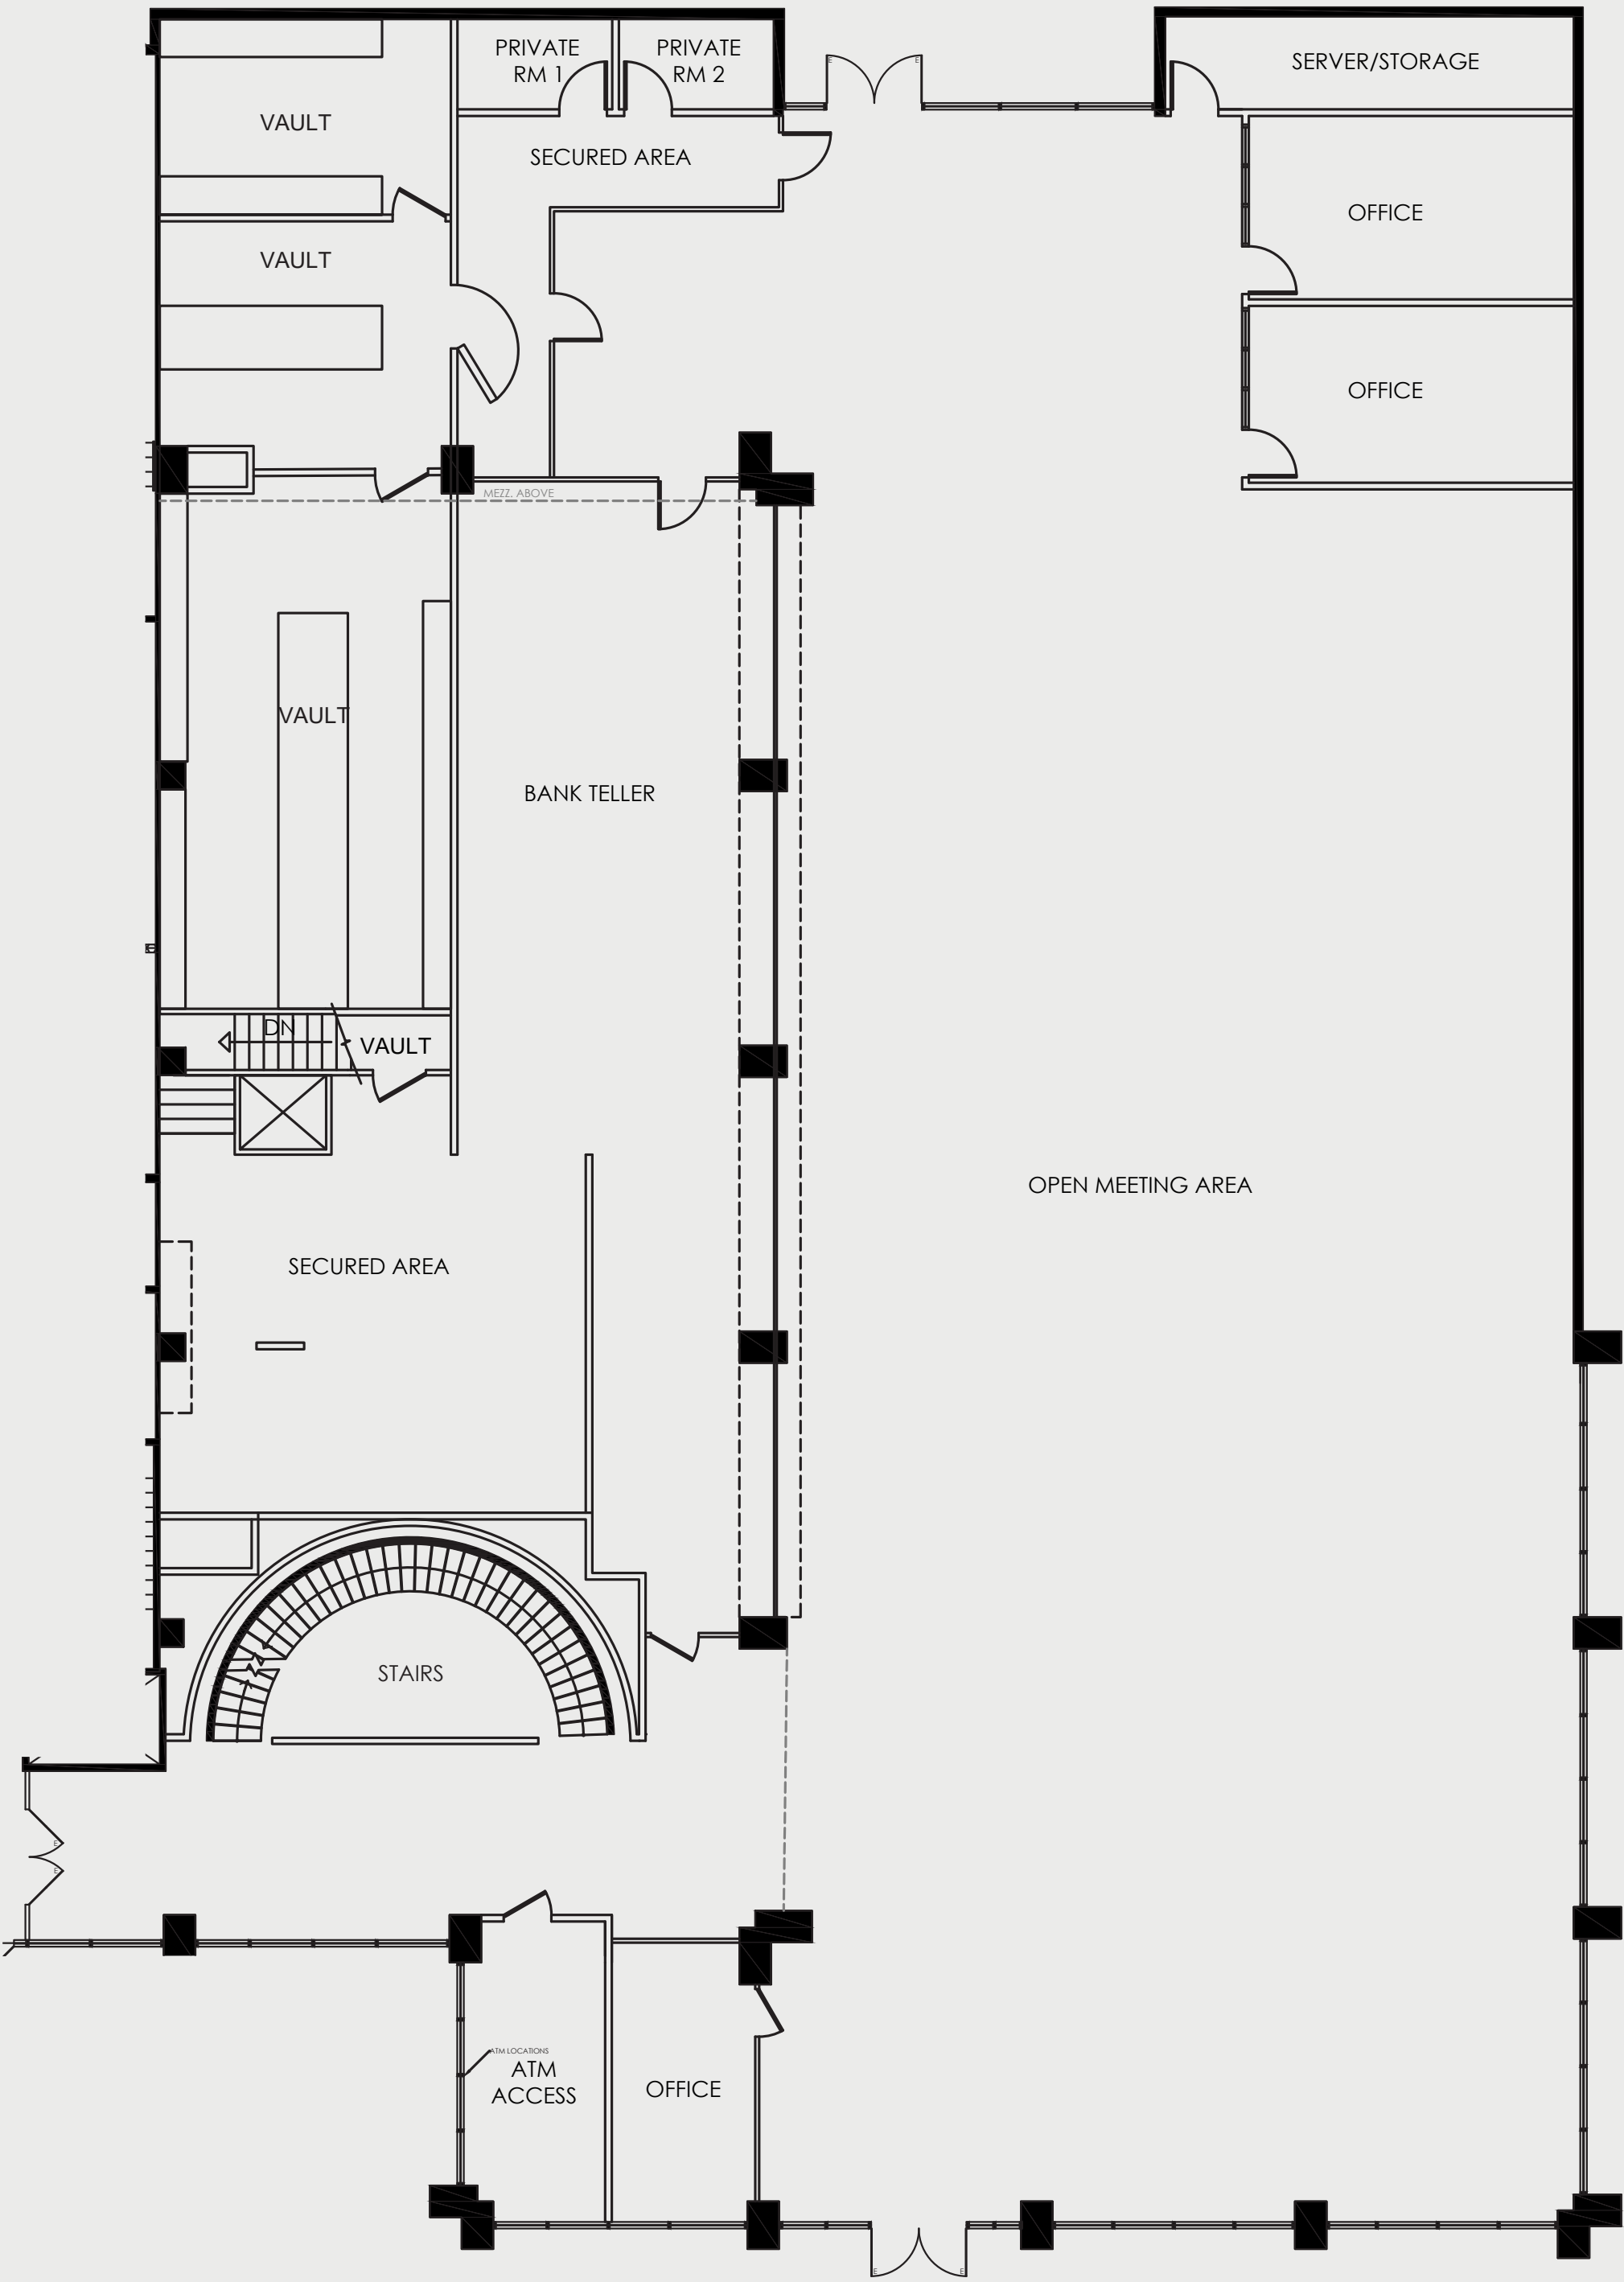

GROUND FLOOR

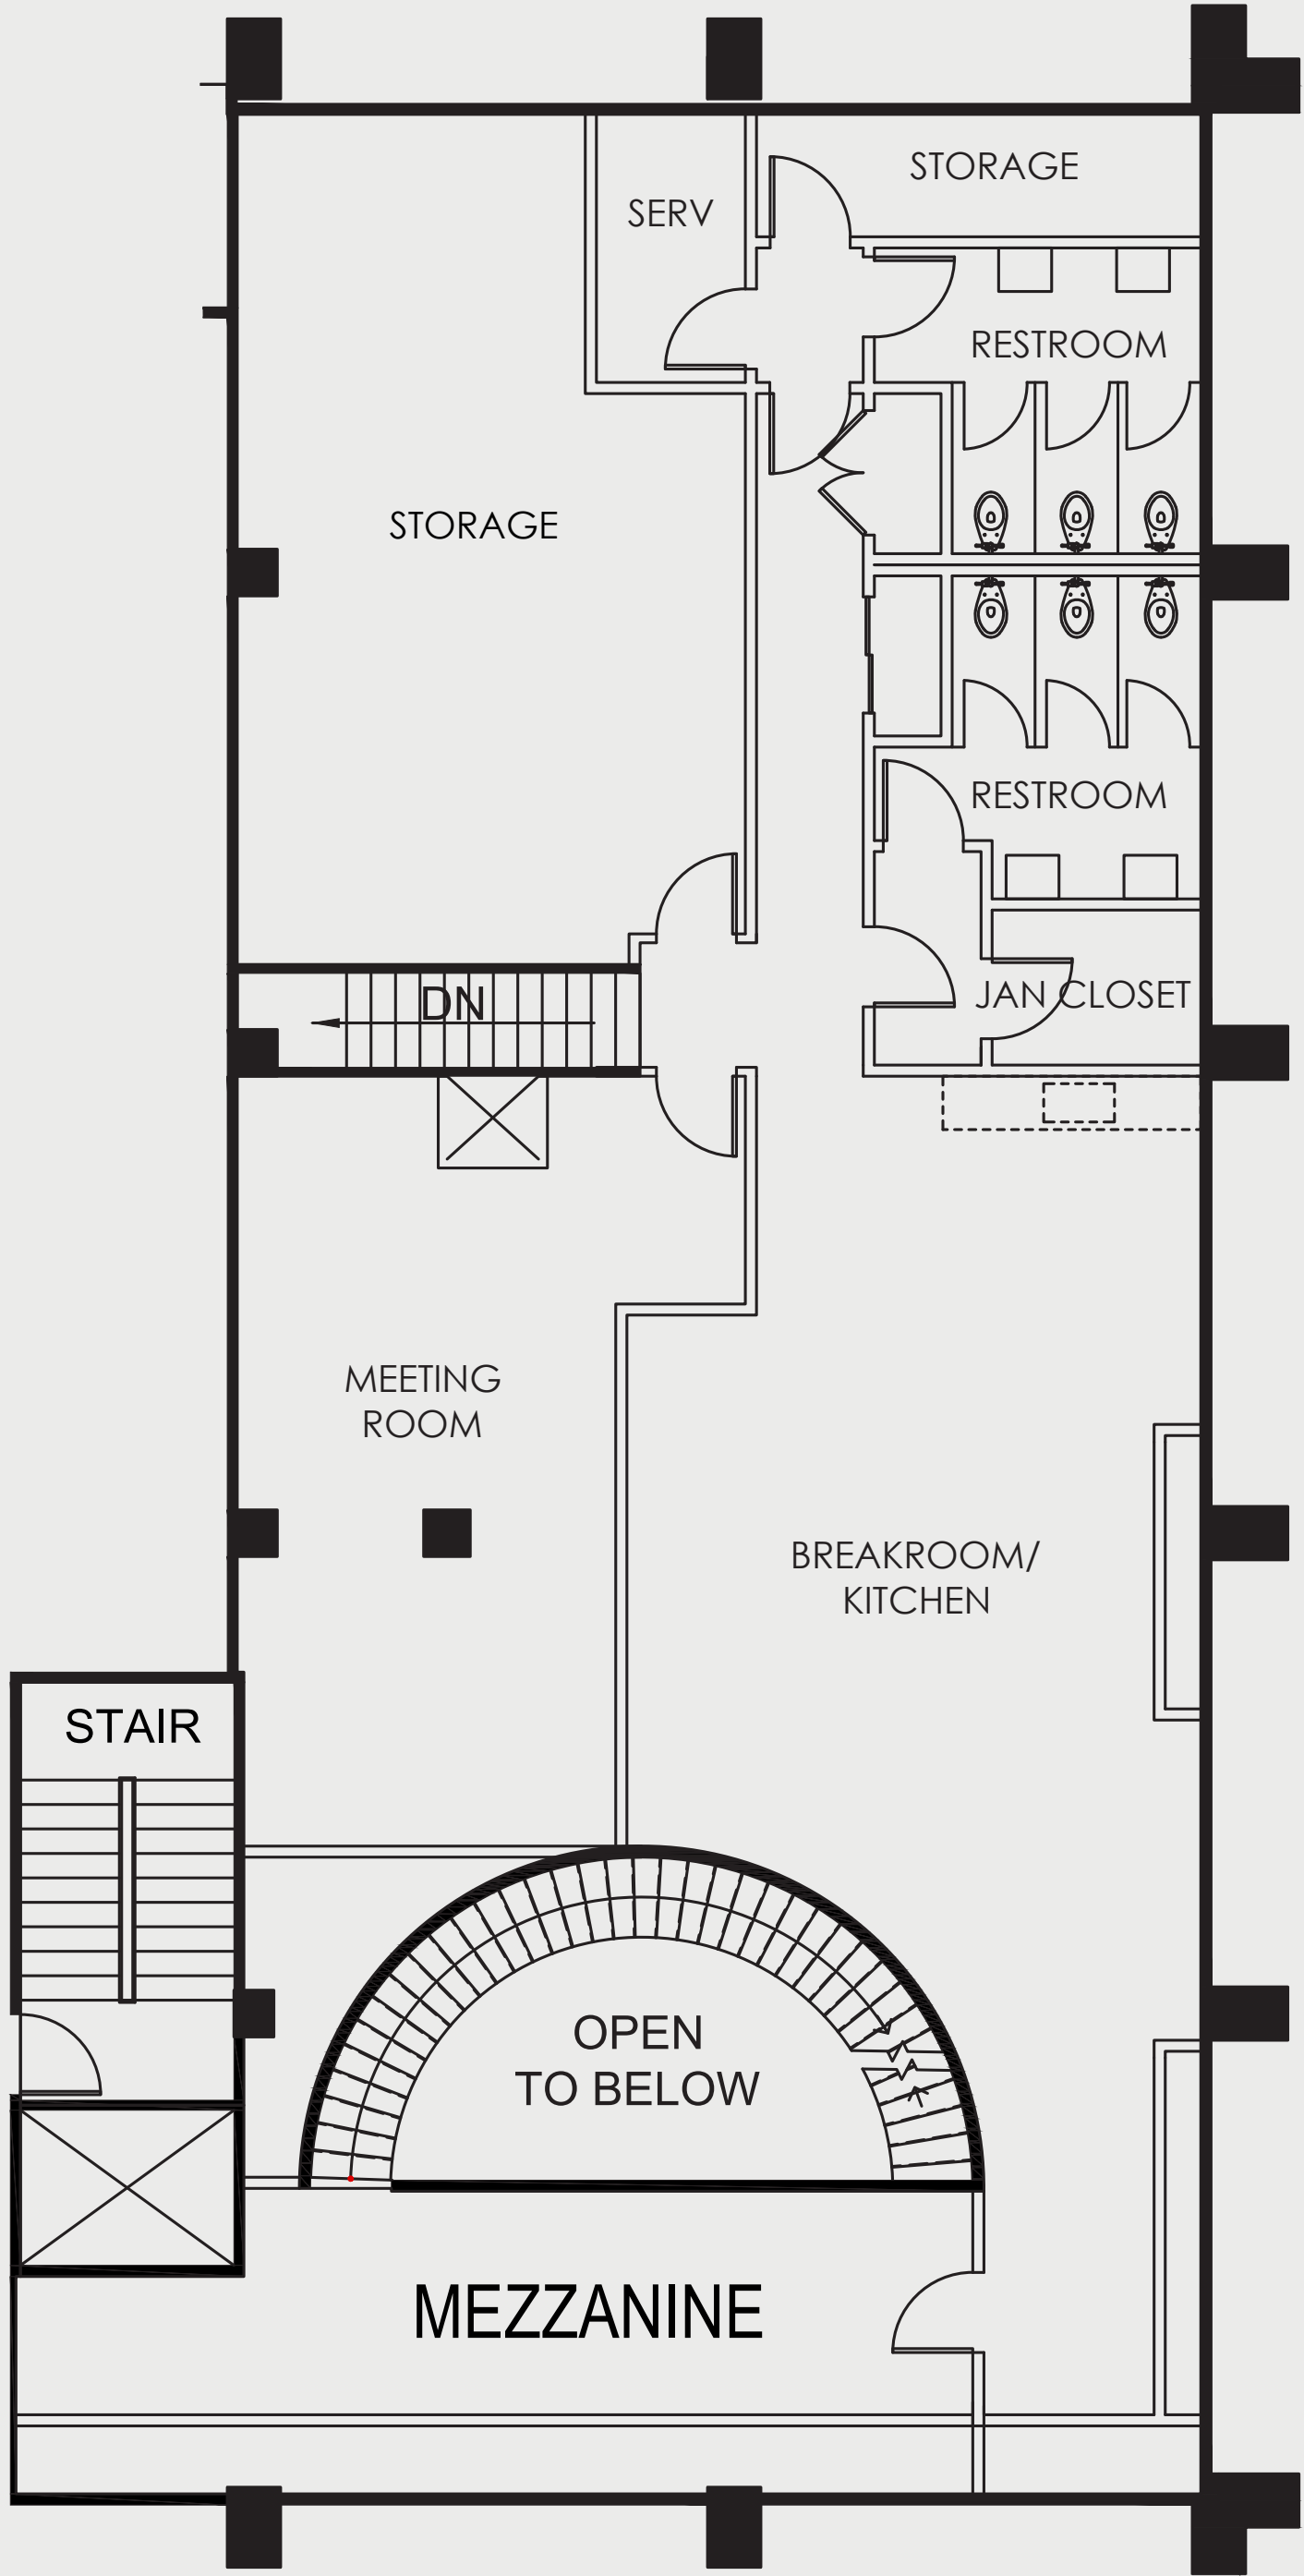

MEZZANINE

For leasing information please contact:
USALEASING@ONNI.COM
(213) 629-2041

