SUITE: 100

RSF: 8,334

east seventh place

AS-BUILT CONFIGURATION

OFFICES..... TBD

RECEPTION..... TBD

CONFERENCE ROOMS..... TBD

KITCHEN..... TBD

OPEN WORK AREA..... TBD

Not to scale, furniture and appliances not included

KEY PLAN

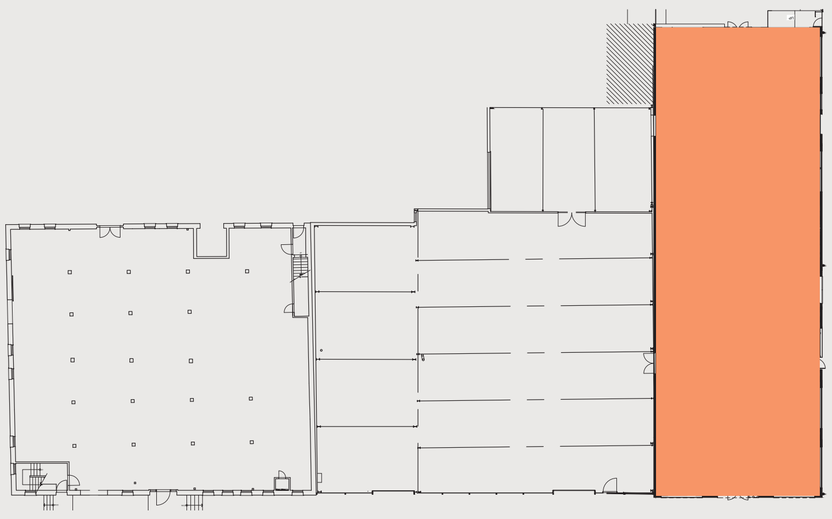

E 7TH PLACE

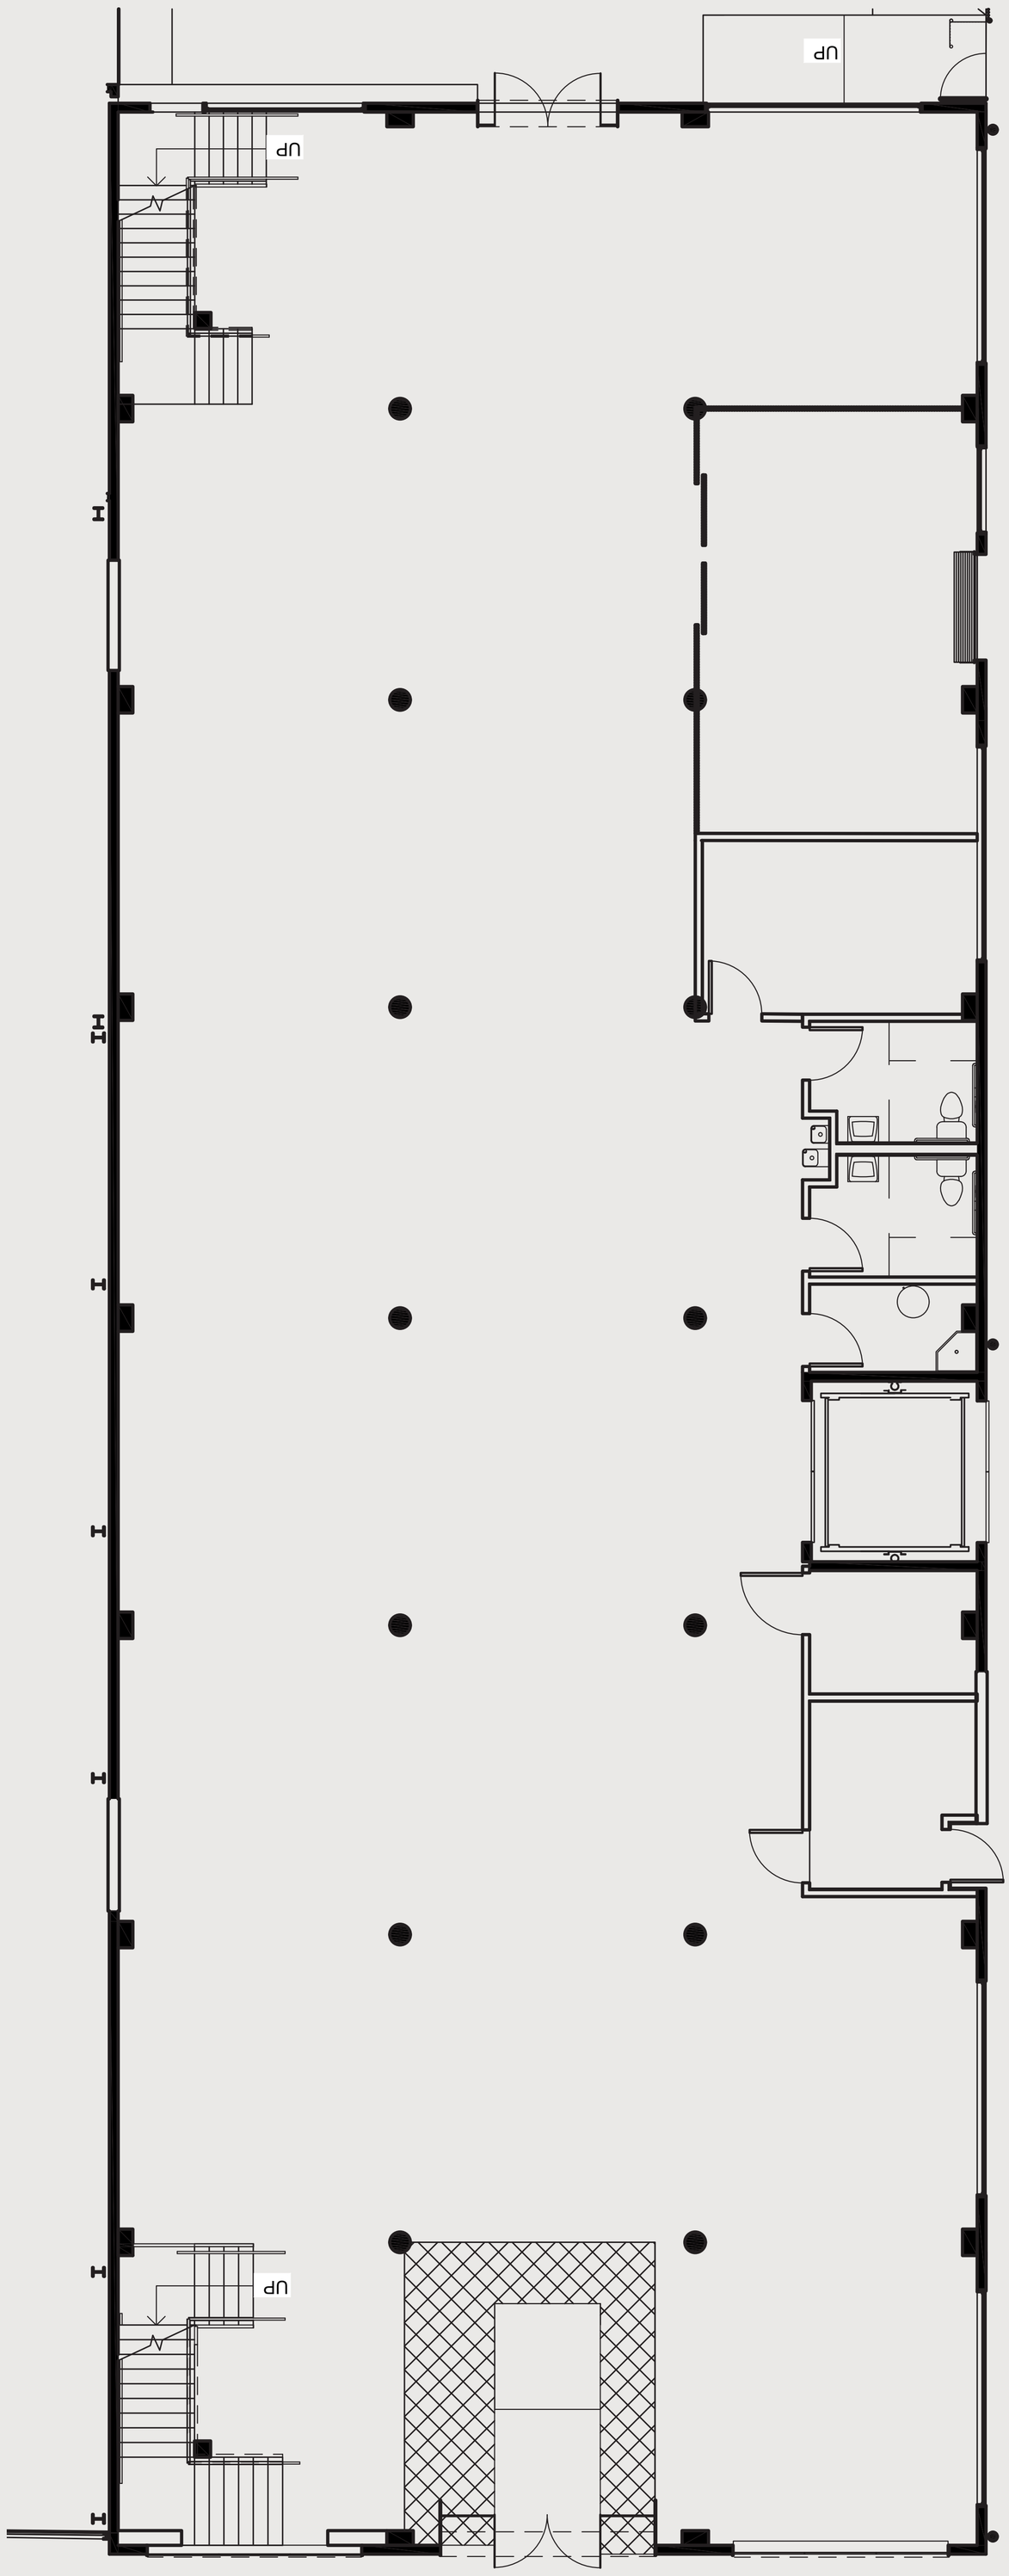

E 7TH PLACE

For leasing information please contact:
Neal Linthicum
310.427.1314 nlinthicum@onni.com

onni group