SUITE:200 RSF: 7,015

east seventh place

AS-BUILT CONFIGURATION

OFFICES	7
RECEPTION	1
CONFERENCE ROOMS	2
KITCHEN	1
OPEN WORK AREA	+/- 34

Not to scale, furniture and appliances not included

KEY PLAN

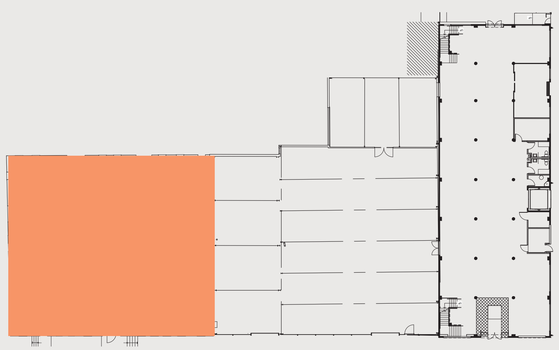

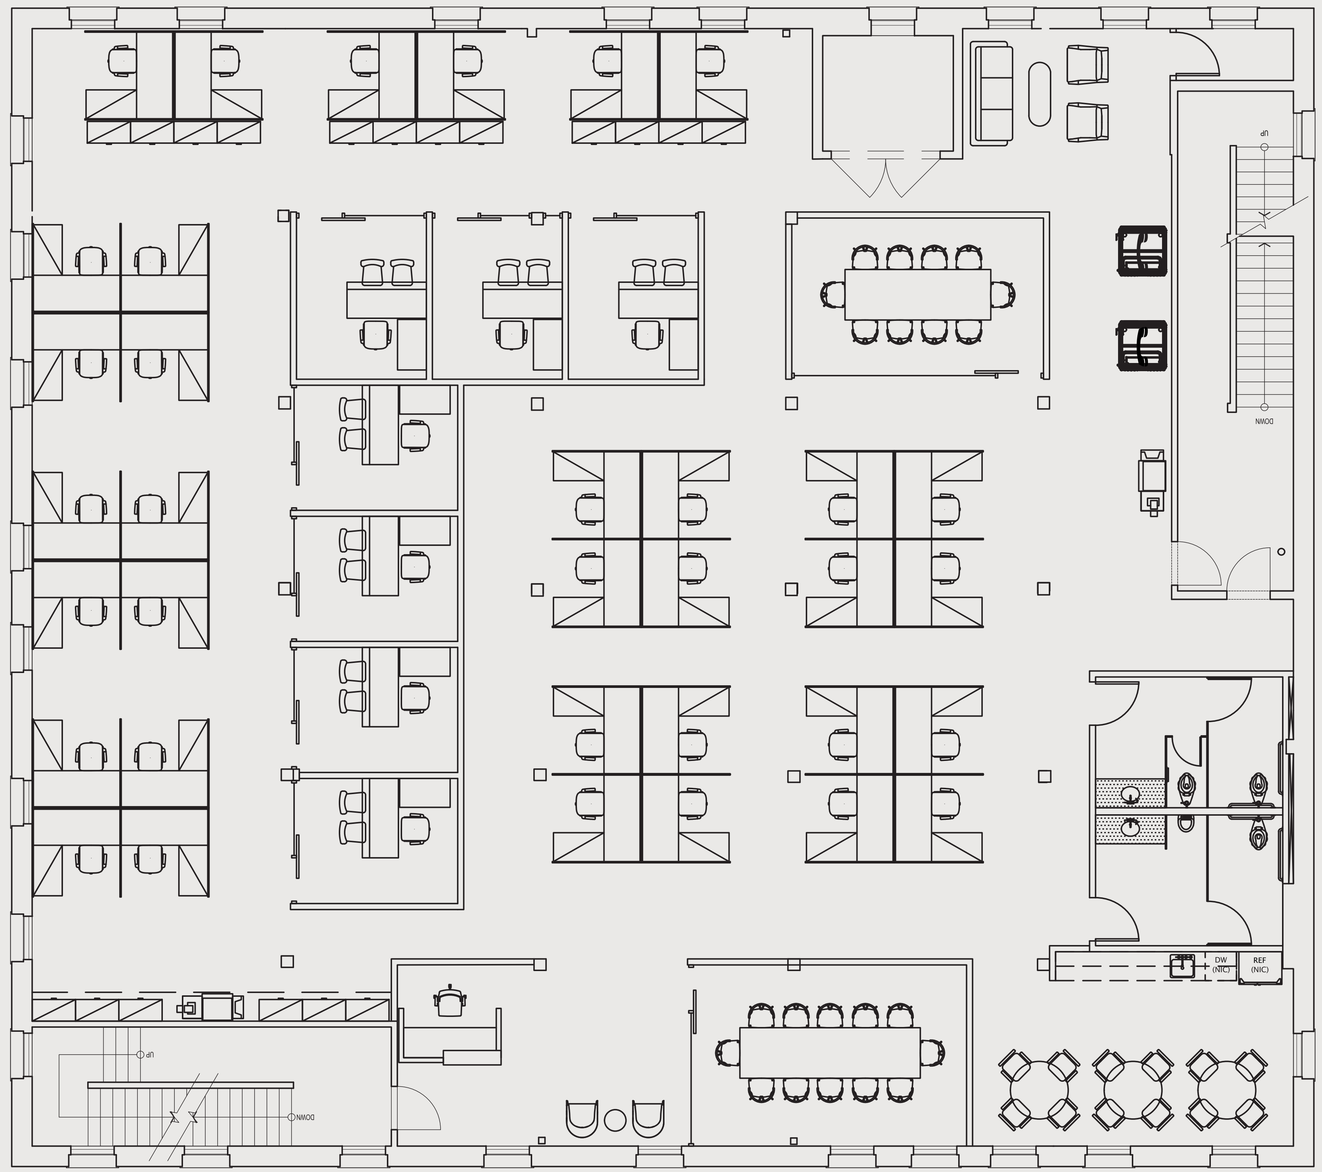

For leasing information please contact:
Neal Linthicum
310.427.1314 nlinthicum@onni.com

onni group