SUITE:300 RSF: 7,220

east seventh place

AS-BUILT CONFIGURATION

OFFICES	6
RECEPTION	1
CONFERENCE ROOMS	4
KITCHEN	1
OPEN WORK AREA	+/- 54

Not to scale, furniture and appliances not included

KEY PLAN

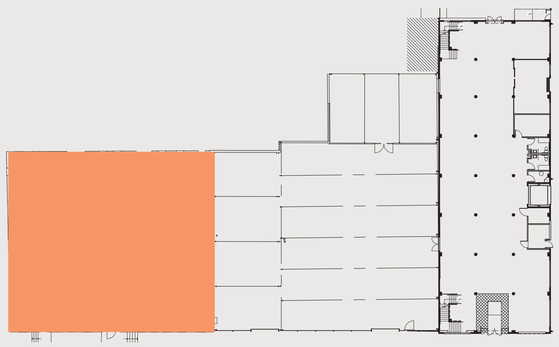

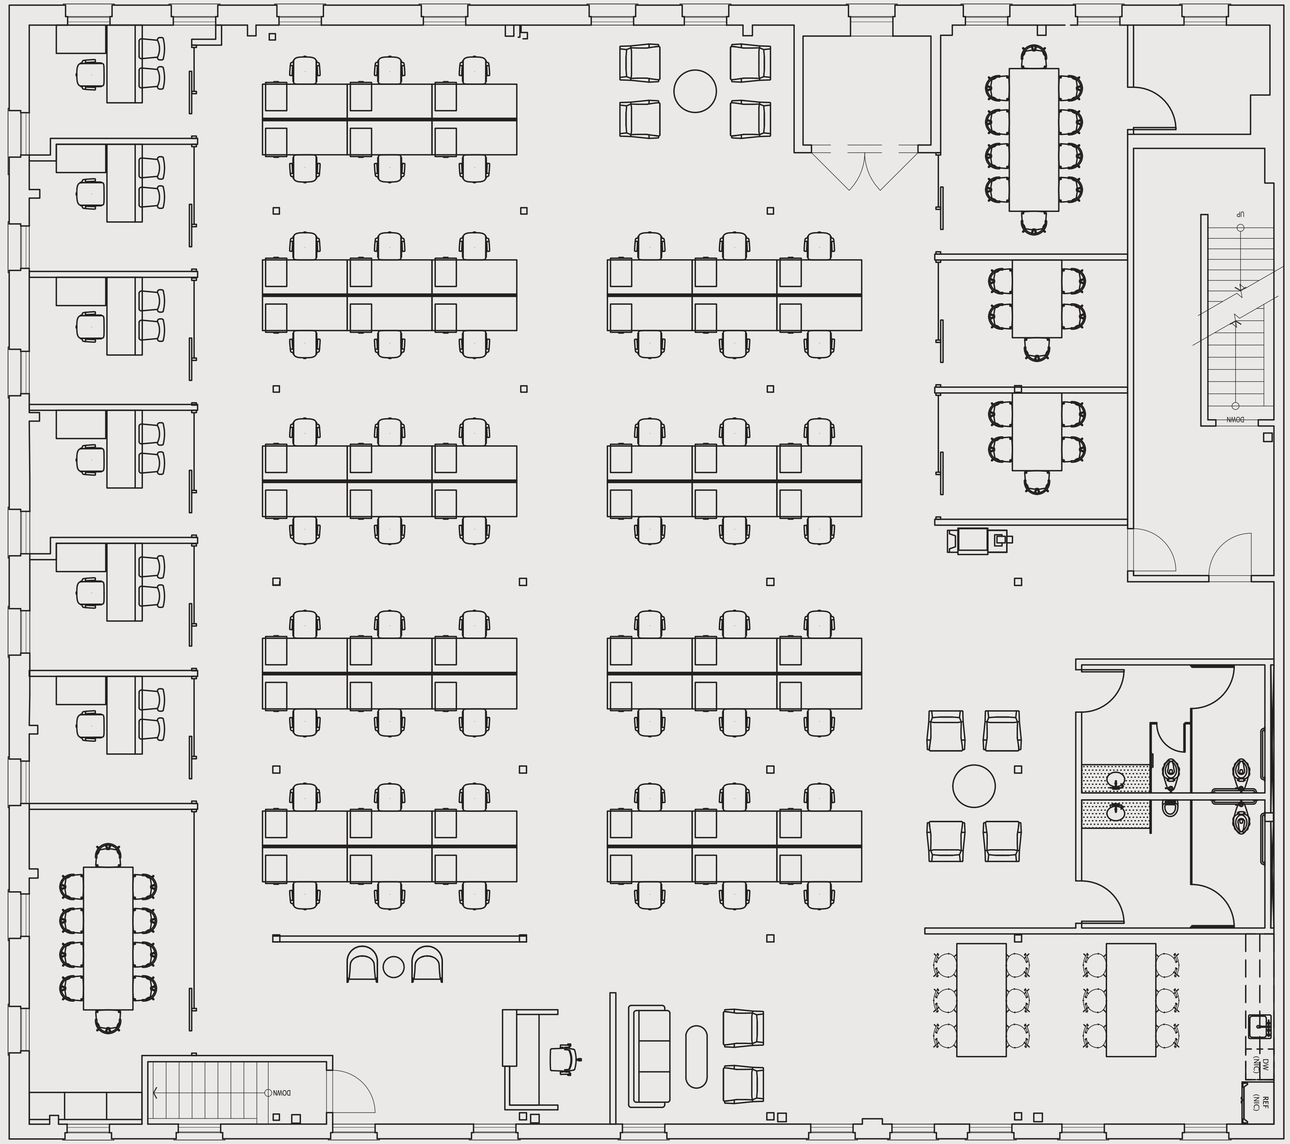

For leasing information please contact:
Neal Linthicum
310.427.1314 nlinthicum@onni.com

onni group