SUITE: 920

RSF: 2,785

700BRAND

AS-BUILT CONFIGURATION

RECEPTION	1
KITCHEN	1
PRIVATE OFFICES	1
CONFERENCE ROOMS	1
OPEN WORK AREA	+/- 21

Not to scale, furniture and appliances not included

KEY PLAN

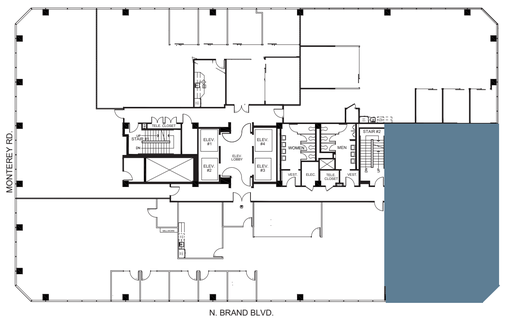

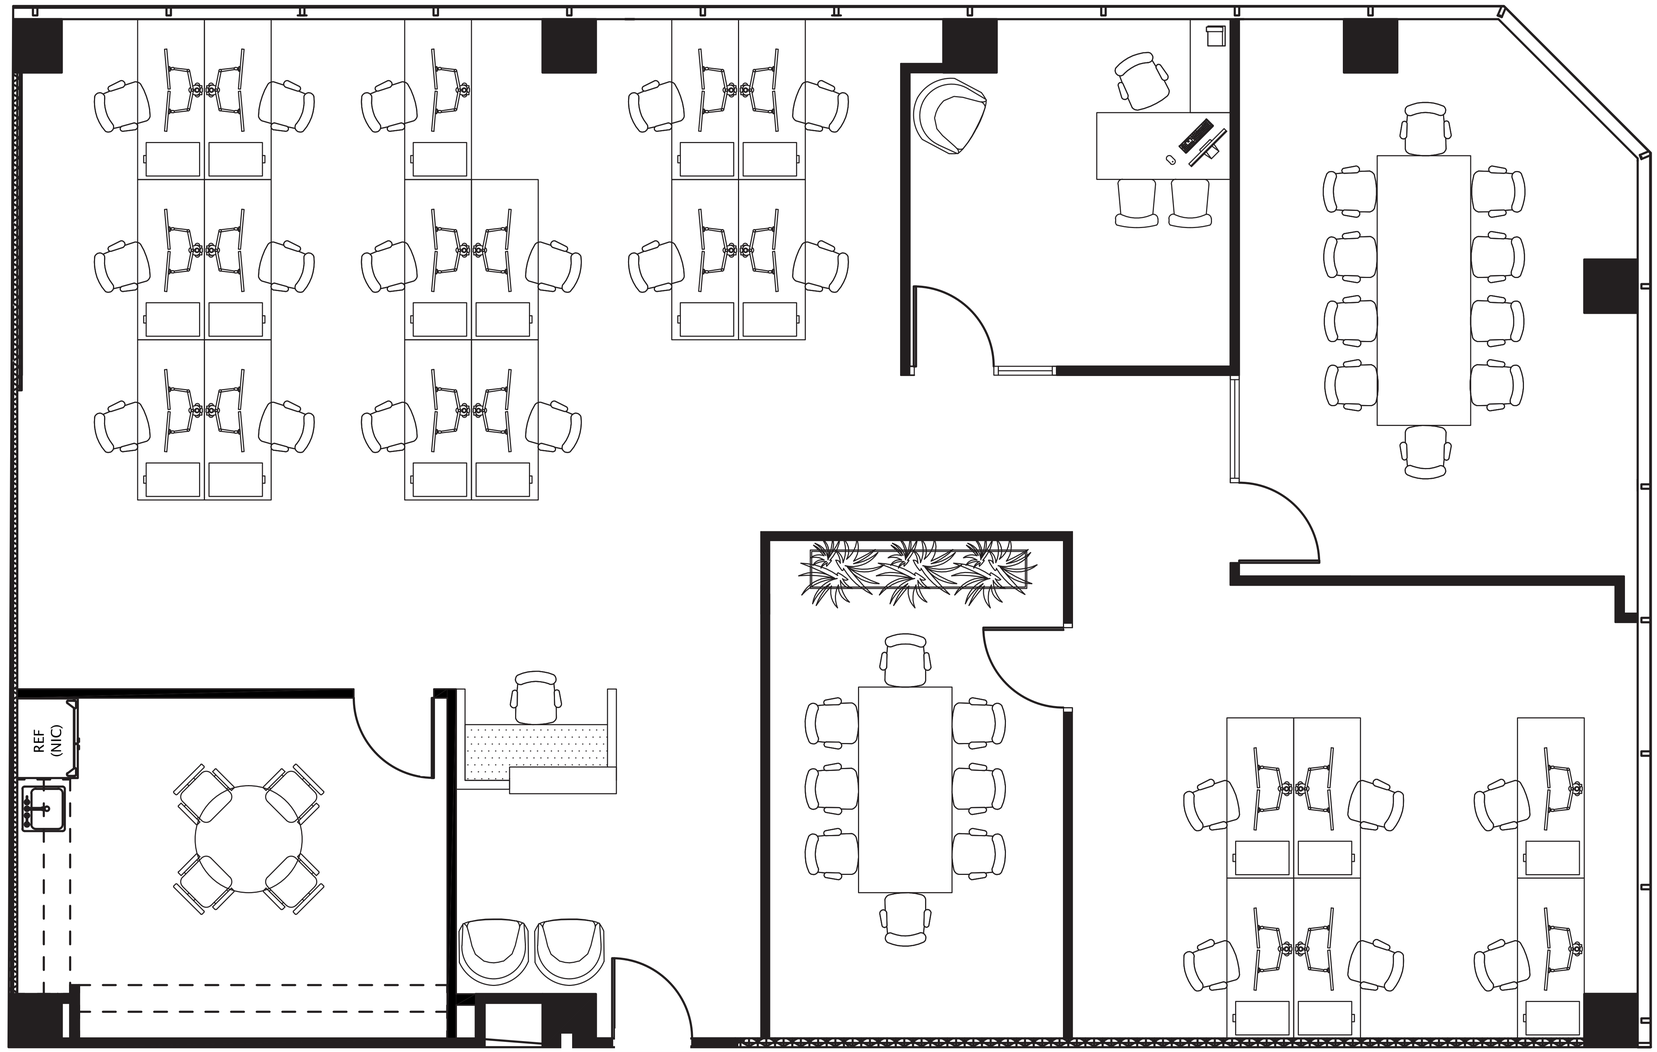

For leasing information please contact:
Scott A. Unger
626.873.1803 | scott.unger@kidder.com